


Section 22 Township 29 Range 34W

Well No. #2 Mossbarger

Company United Prod.

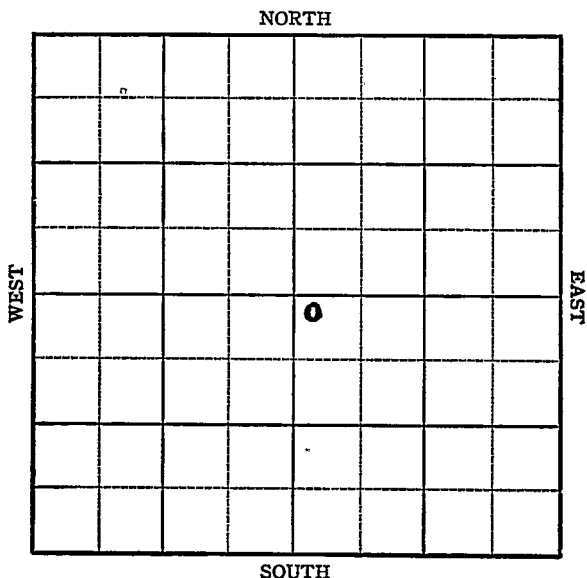

Sec. 22 Twp. 29 R. 34W

Well No. #2 Mossbarger Farm

United Prod. Company


Hughton

100 Ft. from N. Line

 Ft. from S. Line

 Ft. from E. Line

100 Ft. from W. Line

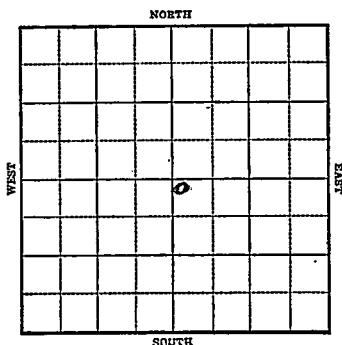

1944

Leu. 2972 REPORT

3/8

10" @ 635
7" @ 2518'
TD 2731
3,400,000 gas.

3/16

6000 acid

3/22

Sand 2518
7" @ 2518
TD 2731
5" liner Perf. @ 2731
8000 acid
8,200,000 Gas

COMPLETED

KANSAS

Map No. N M Sec. 22 Twp. 29 R. 34WWell No. 2 MossbargerUnited Prod.

Company

FIRST REPORT

Contractor

NW SE

SECTION PLAT

100 Ft. from N. Line Ft. from S. Line Ft. from E. Line100 Ft. from W. Line

		0	

Hughton PoolLocation Rig up

Drilling and Remarks:

10" - 635
7" - 2518'

TD 2731

3,400,000 Gas

RECORD

Cased in., ft.Sand Gas Oil Total Depth

PRODUCTION

1st 24 hrs. Nat. 1st 24 hrs. after shot Gas Cu. Ft.Dry Hole Abandoned

Date

MAR 8 1944 19S. J. LEWIS

Scout

KANSAS

Map No. NM Sec. 22 Twp. 29 R. 34 WWell No. 2 MossbargerUnited Prod.

Company

COMPLETED

Contractor

NW SE

SECTION PLAT

100


Ft. from N. Line

Ft. from S. Line

Ft. from E. Line

100

Ft. from W. Line

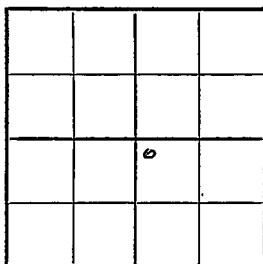Hughton Pool

Location

Rig up

Drilling and Remarks:

Case 2518
7" @ 2518
5" liner pipe @ 2731
8000 acc'd
8,200,000 Gas

RECORD

Cased in., ft.

Sand

Gas

Oil

Total Depth 2731

PRODUCTION

1st 24 hrs. Nat. 1st 24 hrs. after shot Gas Cu. Ft.

Dry Hole

Abandoned

Date

MAR 22 1944 19

S. J. LEWIS

Scout