


Section 22 Township 29 Range 39-W

Well No. #1 Shore

Company Stanolind
Hugoton Pool

NORTH

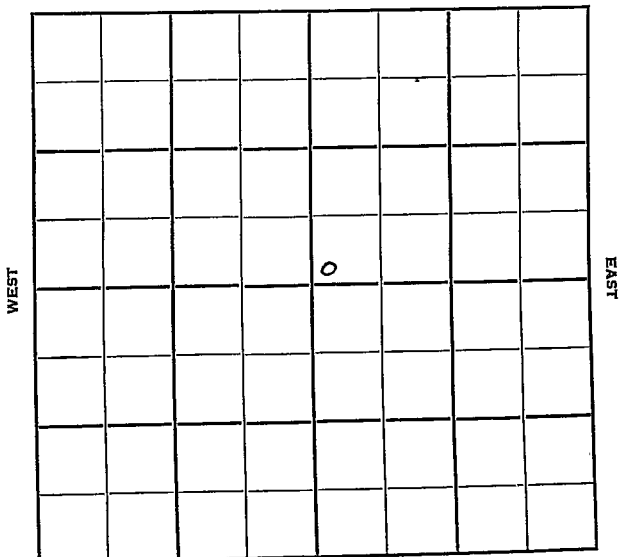

SOUTH

Sec. 22 Twp. 29 R. 39W

Well No. #1 Shore Farm

Stanolind

Company

Hugoton Pool

Contractor

Ft. from N. Line

150'


Ft. from S. Line

Ft. from E. Line

150'

Ft. from W. Line

SW NE

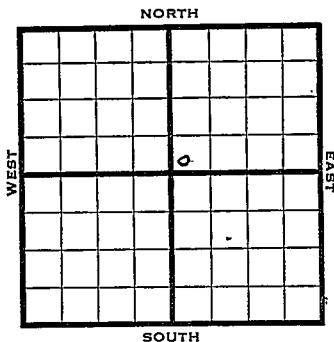

1949

Elev 3182'

REPORT

10/26

Location

11/1

10" @ 608'

11/9

TD 2540'

7" @ 2498'

11/16

1000 acid

412 shots 2437-2358'

11/23

31,000 Acid

11/29

"

12/7

TD 2540'

7" @ 2498'

Perf

32000 acid

6,873,000 Gas

418# R Pr.

Comp

COMPLETED

Map No. _____ Sec. 22 Twp. 29 R. 39W

Well No. 1 Shore

Stanolind Company

Contractor _____

SW NE

**FIRST REPORT
SECTION FLAT**

_____ Ft. from N. Line

150 Ft. from S. Line

_____ Ft. from E. Line

150 Ft. from W. Line

		o	

Stanton County

Location X

Rig up _____

Drilling and Remarks:

RECORD

Cased _____ in., _____ ft.

Sand _____

Gas _____

Oil _____

Total Depth _____

PRODUCTION

1st 24 hrs. Nat. _____

1st 24 hrs. after shot _____

Gas _____ Cu. Ft.

Dry Hole _____

Abandoned _____

Date

OCT 26 1949 19

S. J. LEWIS Scout

Kansas

Map No. _____ Sec. 22 Twp. 29 R. 39W

Well No. 1 Shore

Stanolind Company

COMPLETE

Contractor

SW NE

E. J. R. A.
SECTION PLAT

_____ Ft. from N. Line

150 Ft. from S. Line

_____ Ft. from E. Line

150 Ft. from W. Line

		0	

Stanton County

Location _____

Rig up _____

Drilling and Remarks:

7" C-45
Prof.
8200000000
6,873,000 lbs.
H. J. R. A.

RECORD

Cased _____ in., _____ ft.

Sand _____

Gas _____

Oil _____

Total Depth 3540

PRODUCTION

1st 24 hrs. Nat. _____

1st 24 hrs. after shot _____

Gas _____ Cu. Ft.

Dry Hole _____

Abandoned _____

Date

DEC 7 1949

S. J. LEWIS Scout