


DX 78-1 Kiowa

KANSAS

Section 23 Township 29 Range 17W

Well No. #1 Richard Robbins

Company Barbara Oil & Gas

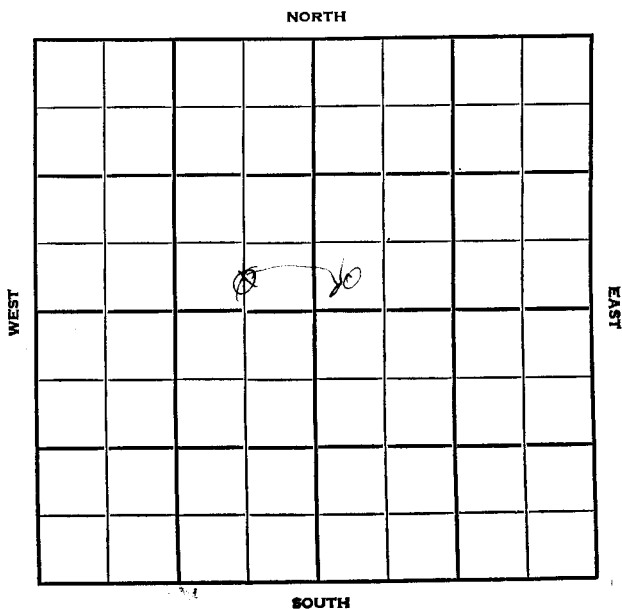

Kiowa

KANSAS

SEC.	TWP.	R.
23	29	17W

WELL NO.

#1 Richard Robbins

FARM

COMPANY

Barbara Oil & Gas

CONTRACTOR

Pickrell


WILDCAT

_____ FT. FROM N. LINE

_____ FT. FROM S. LINE

_____ FT. FROM E. LINE

_____ FT. FROM W. LINE

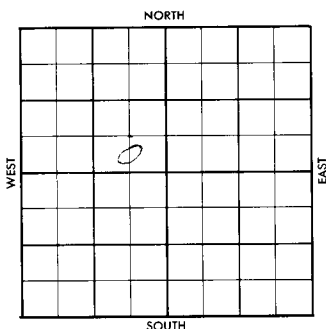

~~C-S¹/₂ SE NW~~

SW SW NE

Gulf - AC

	ELEVATION	REPORT
1956	1942'	
7-11	Comm. 7-8-56 8" @ 320 w/225 Drlg. 1630	
8-1	DST 4616-32 op 2 hrs., gas in 19 min., ga. 210 M/10 min.; 158 mcf in 25 min., rec. 55' GCM, 50-70#. BHP 1280#. DST 4631-50 op 2 hrs. rec. 82 35' SGCM FP 50-60#, 985/20". D & A H. 3865'; D. 3918'; BL. 4035'; L. 4053'; BXG 4390'; L. 4614'; K. 4713'; L. 4745'; TD 4767';	

ABANDONED

28

County **Kiowa** Elev.
 Sec. **23** Twp. **29** Rge. **17W**
 Company **Barbara Oil & Gas**
 Farm Name **Richard Robbins** No. **1**

TOPS	DEPTH	LOG	DATUM
Anh.			
Tr.			
H.			
Tr.			
Dg.			
Bl.			
L.			
K.C.			
B.K.C.			
Ce.			
C.			
M.			
M.			
K.			
Mz.			
Me.			
V.			
S.			
S.			
A.			
R.			
Pe.			
G.			
TD			

Loc. in Sec. **C 3 1/2 SE NW**

Geol.
 Contr. **Pickrell**

Pool **Wildest**

FIRST REPORT	
o	
JUL 11 '56	

Date Comm. **7-8-56** Gulf - AC
 8" @ 320/225 @ 1630

JUL 1 8 1956
 R. G.

CORRECTION

FORM 513 SUNRAY

County Knowa Elev. 1742
 Sec. 23 Twp. 29 Rge. 17W
 Company Pandora Oil & Gas
 Farm Name Richard Robbins No. 1

TOPS	DEPTH	LOG	DATUM	Log in Sec.
Anb.				<u>SUNRAY</u>
TP.				
H.	<u>3865</u>			<u>2310 NL</u>
Tr.				
Dg.	<u>3918</u>			<u>1500 EL</u>
Bl.	<u>4035</u>			
L.	<u>4053</u>			
K.C.				Geol.
B.K.C.	<u>4390</u>			Contr.
Ce.				<u>Pickrell</u>
C.				
M.	<u>4614</u>			Pool
M.				<u>Wildcat</u>
K.	<u>4713</u>			
Mz.				
Me.				
V.	<u>4745</u>			
S.				
S.				
A.				
R.				
Pe.				
G.				
TD	<u>4767</u>			

ABANDONED

Date Comm. 7-8-56 Gulf - AC
 8" 320/225 210 M. 1630 JUL 12 '56 3800
 JUL 25 '56 DST 4616-32 2 hrs 9/19"
 90 210 M / 10" 158 MCI = 125'
 rec. 55' GCM 50-70 BHP
 1280/ DST 4631-50 2 hrs
 rec. 35' 5 GCM ~~FP~~ FP 50-60
 985/20" ahead AUG 1 '56

O & A