


KANSAS Sedgwick

Section 23 Township 29 Range 1W

Well No. 1 Roy

Company Chas. Carlock

Wildcat
NORTH

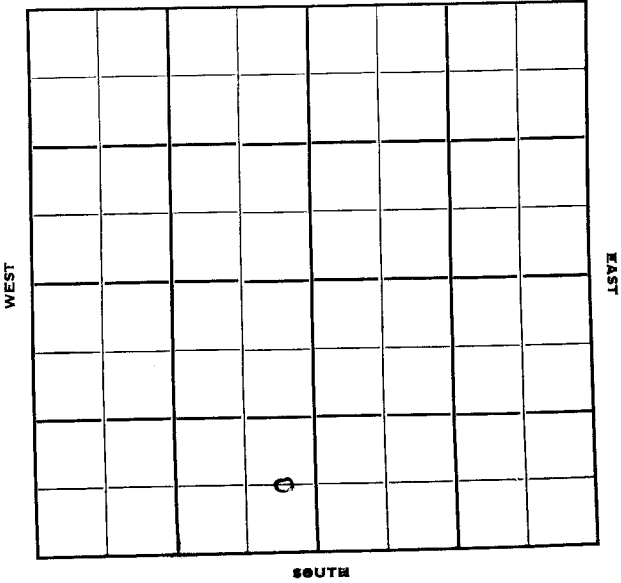

Sedgwick

KANSAS

Sec. 23 Twp. 29 R. 1W

Well No. #1 Roy Farm

Chas Carlock Company

Wildcat

Ft. from N. Line


660'

Ft. from S. Line

330'

Ft. from E. Line

Ft. from W. Line

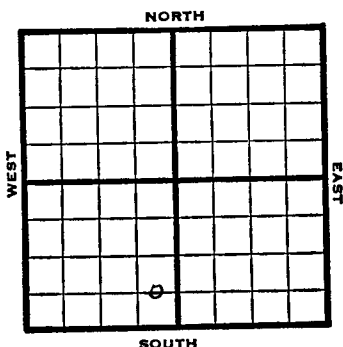

C E L SE SW

1949	Elev. 1281'	REPORT
10/19	TD 3384'	
10/26	Miss 3375'	
	TD 3385'	
	ABANDONED	

Map No. _____ Sec. 23 Twp. 29 R. 1W

Well No. 1 Roy

Chas. Carlock Company

Eckland Contractor

C E L S E S W


**FIRST REPORT
SECTION PLAT**

_____ Ft. from N. Line

660 Ft. from S. Line

330 Ft. from E. Line

_____ Ft. from W. Line

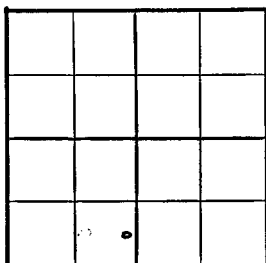

Sedgwick County

RECORD

Location _____

Cased _____ in., _____ ft.

Rig up _____

Sand _____

Drilling and Remarks:

Gas _____

Oil _____

Total Depth _____

3384 TD

PRODUCTION

1st 24 hrs. Nat. _____

1st 24 hrs. after shot _____

Gas _____ Cu. Ft.

Dry Hole _____

Abandoned _____

Date

OCT 19 1949

19

S. J. LEWIS Scout

Map No. _____ Sec. 23 Twp. 29 R. 1W

Well No. 1 Roy

Chas. Carlock Company

ABANDONED Contractor

C E L SE SW


E 11/28/
SECTION PLAT

_____ Ft. from N. Line

660 Ft. from S. Line

330 Ft. from E. Line

_____ Ft. from W. Line

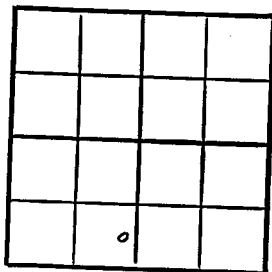

Sedgwick County

Location _____

Rig up _____

Drilling and Remarks:

Miss 3825

RECORD

Cased _____ in., _____ ft.

Sand _____

Gas _____

Oil _____

Total Depth 2385

PRODUCTION

1st 24 hrs. Nat. _____

1st 24 hrs. after shot _____

Gas _____ Cu. Ft.

Dry Hole _____

Abandoned _____

Date

OCT. 22 1940

19

S. J. LEWIS

Scout