
Sedgwick KANSAS

SECTION 23 TOWNSHIP 29S RANGE 2W

WELL NO. #2 Senter

COMPANY Joe Neuman

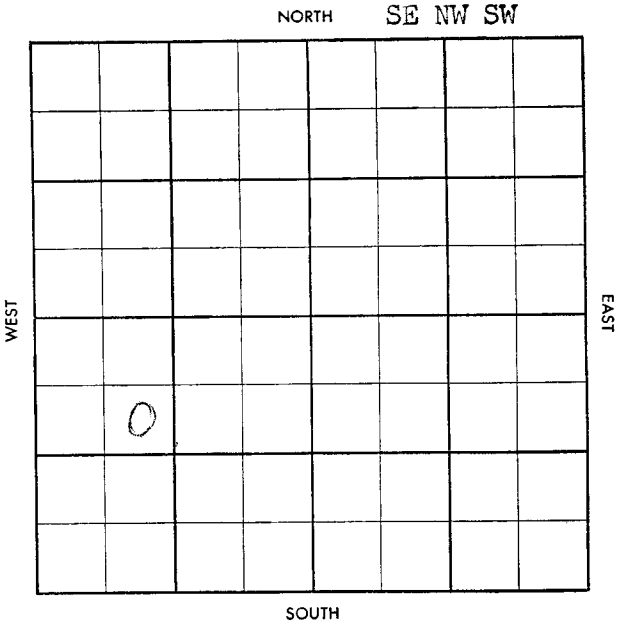

FORM 504-3 SUNRAY

28

S-513-A

CO. Sedgwick ELEV.

SEC. 23 TWP. 29 RGE. 2W

COMPANY Joe Neuman NO. 2

FARM Senter

LOC. SE NW SW

FIRST REPORT

JAN 15 '58

GEOL. Glen Thrasher

CONTR. Peak Tools #14

POOL Clearwater

SPUD 1/9/58

8" @ 385 w/250, Drlg. 2160.

CO.

LSE.

NO.

SEC.

TWP.

RGE.

S-513-A

CO. Sedgwick ELEV. 1311 KB

SEC. 23 TWP. 29 RGE. 2W

COMPANY Joe Neuman NO. 2

COMPLETE
MAR 12 '58

FARM Senter

LOC. SE NW SW

L 2598
Sta/n 2678
kc 2931

TD 3055

GEOL Glen Thrasher

CONTR Peak Tools #14

POOL Clearwater

SPUD 1/9/58

8" @ 385 w/250, Drlg.

2160. no log

5½" 3052

FEB 13 '58

SD

CO 29/2941

-46 (¼) (¼) $ 6304 NW

NT pay

P 2580 pd + tw

kc-T

CO. LSE. NO. SEC. TWP. RGE.