

Kingman

KANSAS

23

29

8W

SECTION _____ TOWNSHIP _____ RANGE _____

#1 Duckworth


WELL NO. _____

Prime Drlg. & T.K. Travis

COMPANY _____

NORTH

S/2 SE SE

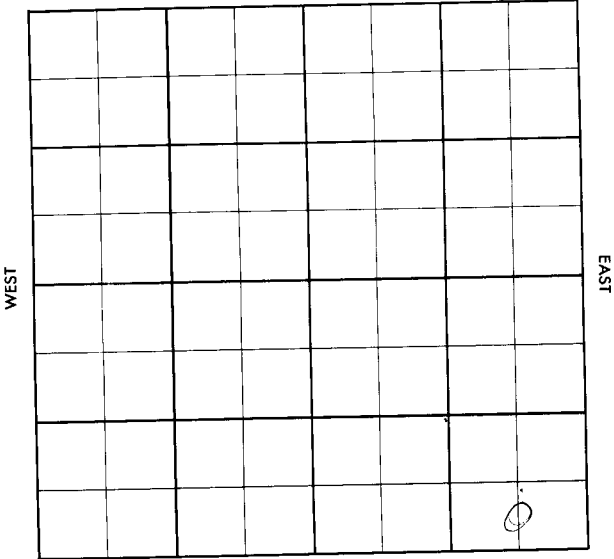

SOUTH

Kingman

KANSAS

SEC.

TWP.

R.

23

29 S

8 W

WELL NO.

1 Duckworth

FARA

COMPANY

Prime Drlg. & T. K. Travis

CONTRACTOR

Prime Drlg.

Wildcat


____ FT. FROM N. LINE

____ FT. FROM S. LINE

____ FT. FROM E. LINE

____ FT. FROM W. LINE

NORTH

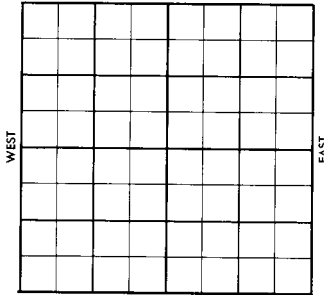

SOUTH

S/2 SE SE

SDX-1/2 Mile

Continent-FO. Mag. (Ac. Cont.) Sinclair & Gul

(DPM)

1957

ELEVATION

REPORT

3/6

Comm. 3-1-57
8" @ 261/200
Drlg. 1410'

(on Tkt)

WILDCAT

County Kingman

Elev. _____

Sec. 23Twp. 29Rgs. 8WCompany Prime Drlg. & T. K. TravisFarm Name DuckworthNo. 1

TOPS	DEPTH	LOG	DATUM	Loc in Sec.
Anh.				<u>S/2 SE SE</u>
TP.				
H.				
Tr.				
Dg.				
Bl.				
L.				
N.C.				Geol. _____
B.K.C.				Contr. _____
Ce.				<u>Prime Drlg.</u>
C.				Reel _____
M.				<u>Wildcat</u>
M.				
K.				
Mz.				
Me.				
V.				
S.				
S.				
A.				
R.				
Pe.				
G.				
TD.				

SDX-1/2-1118
FIRST REPORT

MAR 6 '57

Date Comm. 3-1-57 Continental (FO) Mag. (ac. Cor)
 Sinclair & Gulf (DHR)
8" @ 261/200, Drlg. 1410

27

