


KANSAS

Grant

Section 23 Township 29 Range 35W

Well No. #1 G.W. Bangham BLACKWELER

Company United Producing

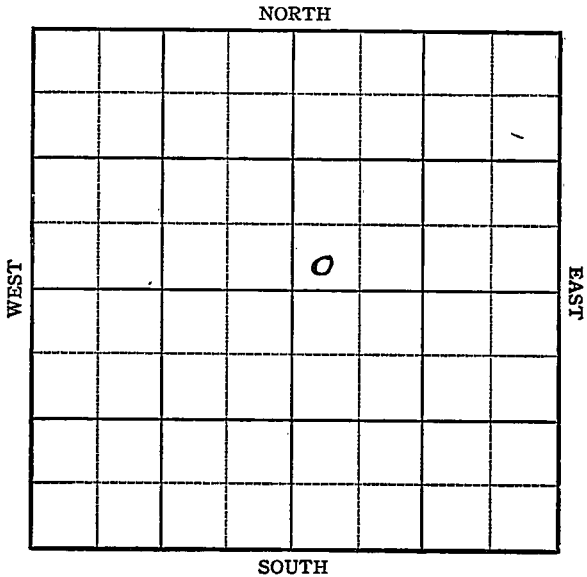


KANSAS

Grant

Sec. 23 Twp. 29 R. 35WWell No. #1 G.W. Bangham BLACKWELL FarmUnited Producing Company

Hugoton Gas

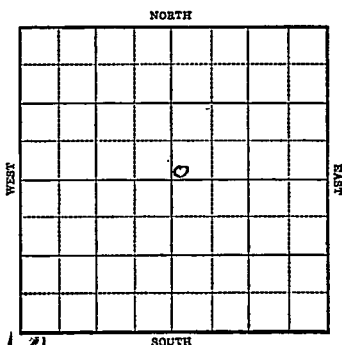2540 Ft. from N. Line Ft. from S. Line2540 Ft. from E. Line Ft. from W. LineElv. 3040

1944

R E P O R T

2/23

10" @ 655 r/ 9.5'

Drlg. 900'

3/1

Drlg. 1340

3/8

7" @ 2620

Rust

3/16

"

3/22

"

3/29

SS Gas 2553

Drlg. 2590

4/5

TD 2746

2.300.000 Gas

4/12

" " "

4/19

7" @ 2520

Sand 2520

TD 2746

8000 acid

10 1/2 M Gas

COMPLETED

KANSAS

Map No. 10/101 Sec. 23 Twp. 29 R. 35WWell No. 1 G. W. BanghamUnited Producing

Company

FIRST REPORT

Contractor

SW NE


SECTION PLAT

2540 Ft. from N. Line

Ft. from S. Line

2540 Ft. from E. Line

Ft. from W. Line

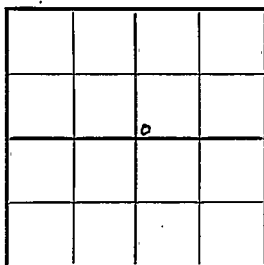Hugoton Gas Pool

Location

Rig up

Drilling and Remarks:

10" - 655

900'

RECORD

Cased _____ in., _____ ft.

Sand _____

Gas _____

Oil _____

Total Depth _____

PRODUCTION

1st 24 hrs. Nat. _____

1st 24 hrs. after shot _____

Gas _____ Cu. Ft.

Dry Hole _____

Abandoned _____

Date

FEB 23 1944 19

S. J. LEWIS Scout

KANSAS
 Map No. 1777 Sec. 23 Twp. 29 R. 35W

Well No. 1 Blackweler

United Prod.

Company

CORRECTION

Contractor

SW NE


SECTION PLAT

2540 Ft. from N. Line

_____ Ft. from S. Line

2540 Ft. from E. Line

_____ Ft. from W. Line

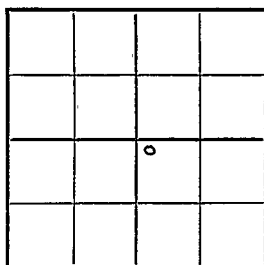

Hugoton Gas Pool

Location _____

Rig up _____

Drilling and Remarks:

Reported

#1 G.W. Bingham

RECORD

Cased _____ in., _____ ft.

Sand _____

Gas _____

Oil _____

Total Depth _____

PRODUCTION

1st 24 hrs. Nat. _____

1st 24 hrs. after shot _____

Gas _____ Cu. Ft.

Dry Hole _____

Abandoned _____

Date

MAR 8 1944 19

S. J. LEWIS Scout

KANSAS Pool Name Hugoton Gas
 Map No. 177M Sec. 23 Twp. 29 R. 35W
 Well No. 1 Blackwater

United Producing Company

COMPLETED Contractor

SW NE


SECTION PLAT

2540 Ft. from N. Line

_____ Ft. from S. Line

2540 Ft. from E. Line

_____ Ft. from W. Line

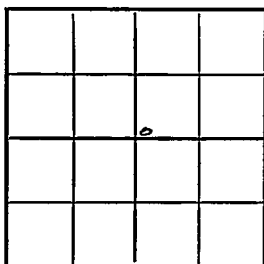

Grant County

Location _____

Rig up _____

Drilling and Remarks:

Same 2520

7" @ 2520

8000 acid

10 1/2" H. Gas

RECORD

Cased _____ in., _____ ft.

Sand _____

Gas _____

Oil _____

Total Depth 2746.

PRODUCTION

1st 24 hrs. Nat. _____

1st 24 hrs. after shot _____

Gas _____ Cu. Ft.

Dry Hole _____

Abandoned _____

Date

APR 19 1944 19

S. I. LEWIS Scout