


Section 24 Township 29 S Range 16 W

Well No. #2 Piester

Company G-M-R

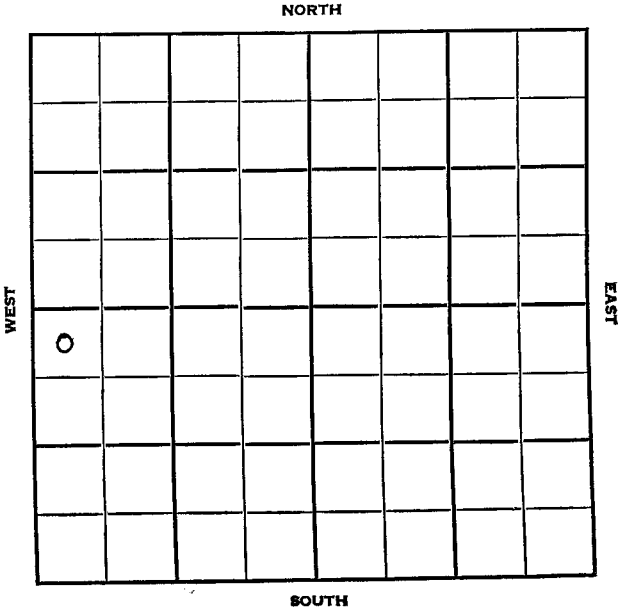

SEC.	24	TWP.	29S	R.	16W
------	----	------	-----	----	-----


WELL NO. #2 Piester FARM

COMPANY G-M-R

CONTRACTOR Co Tools

Soldier Creek

\_\_\_\_\_ Ft. from N. Line  
 \_\_\_\_\_ Ft. from S. Line  
 \_\_\_\_\_ Ft. from E. Line  
 \_\_\_\_\_ Ft. from W. Line

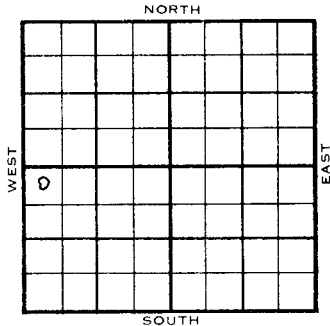

NW NW SW

	ELEVATION	REPORT
1955	1941'	
9/28	Comm 9-2-55 8" @ 357 w/250 Anh 839 D 1216	
10/19	Comm 9-2-55 8" @ 357/250 Anh 839 H 3876 Tr 3895 Dg 3929 Bl 4043 l 4061 Ce Sd 4677 M 4594 TD 4670 DST 4494-4525 open 1 hr Rec 25' mud 0/30# DST 4574-90 open 1 hr Rec 15' mud 0/30# DST 4585-4642 open 1 hr Rec 50' mud 150/30" D & A	

**ABANDONED**

County Kiowa Elev. \_\_\_\_\_

Sec. 24 Twp. 29S Rgs. 16W

Company Oil

Farm Name Master No. 2

TOPS	DEPTH	LOG	DATUM	Loc. in Sec.
Anh.	<b>839</b>			<u>NE 1/4 24</u>
TP.				
H.				
Tr.				
Dg.				
BL.				
L.				
K.C.				Geol. _____
B.K.C.				Contr. _____
Ce.				
C.				<u>Co tools</u>
M.				
M.				
K.				Pool _____
Mz.				<u>Soldier Creek</u>
Mo.				
V.				
S.				
S.				
A.				
R.				
PE.				
G.				
T.D.				

FIRST REPORT


ate Comm. 9-2-55 SEP 28 1955

8" 357 w/250; U 1216

25

County Kiowa Elev. 1941  
 Sec. 24 Twp. 29 Rge. 16W  
 Company G-M-R  
 FarmName Piester No. 2

TOPS	DEPTH	LOG	DATUM
Anb.	839		
Tp.			
H.	376		12.5
Tr.	375		14.4
Dg.	339		17.8
Bl.	443		21.2
L.	461		22.5
K.C.			
B.K.C.			
Ce.	4577		26.36
C.			
M.	4574		26.55
M.			
K.			
Mz.			
Me.			
V.			
S.			
S.			
A.			
R.			
PE.			
G.			
TD.	4670		

Loc. in Sec. \_\_\_\_\_  
 NW NW SW  
 Geol. \_\_\_\_\_  
 Contr. \_\_\_\_\_  
 Co. tools \_\_\_\_\_  
 Pool \_\_\_\_\_  
 Soldier Creek  


Date Comm. 9-2-55 OCT 19 1955  
8" @ 357/250 DST 4494-4525 open 1 hr.  
Rec. 25' mud 0/30" DST 4574-90  
open 1 hr. rec. 15' mud 0/30"  
DST 4585-4612 open 1 hr. rec. 50' mud  
150/30"

D & A