


Section 24 Township 29 Range 14W

Well No. 5 Andrews

Company Lion Oil Ref.

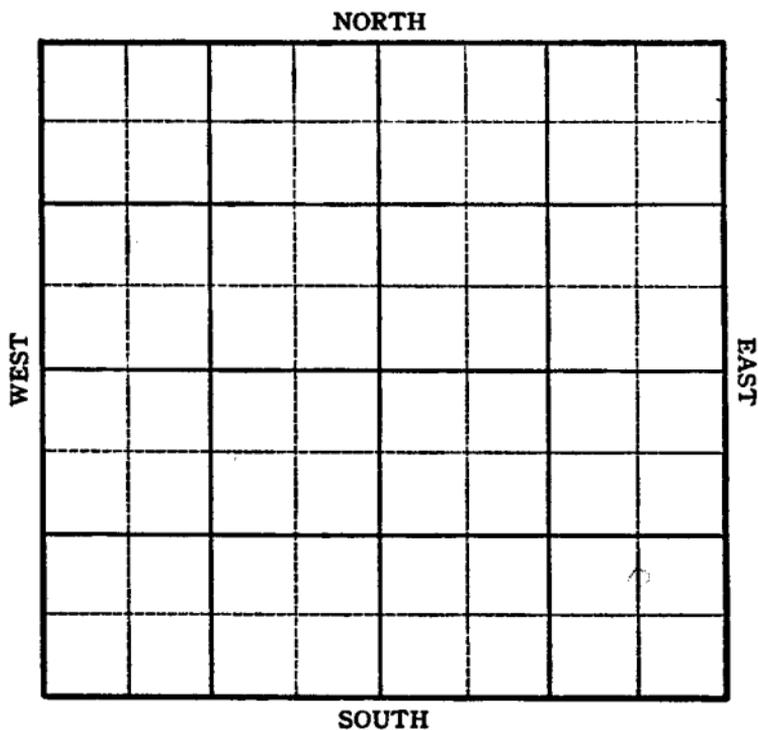

Sec. 24 Twp. 29 R. 14-W

Well No. #5 Andrews Farm


Lion Oil Ref. Company

_____ Ft. from N. Line

990 Ft. from S. Line

660 Ft. from E. Line

_____ Ft. from W. Line

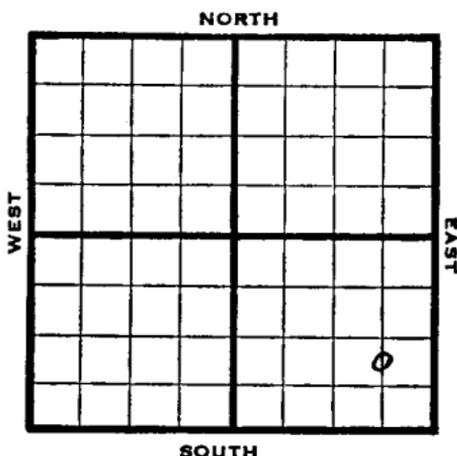

C N L SE SE

1945 Elev. 1960 REPORT

- 11/7 Location
- 11/14 10" @ 500
Drlg. 1970'
- 11/21 3383 fsg.
- 11/28 Drlg. 4310'
- 12/5 Simp Sh 4315
TD 4356
Run 5"
- 12/12 Arb. 4326 corrected
TD 4460
5" @ 4459 RUST
- 12/19 Arb. 4326
5" @ 4459
TD 4460

ABANDONED

KANSAS Kansas Pool Name Shriver

Map No. K. 92 Sec. 24 Twp. 29 R. 14W

Well No. 5 Andrews

Lion Oil Company

ABANDONED

Contractor

C. L. SE SE

E. 1960
SECTION PLAT

 Ft. from N. Line

900 Ft. from S. Line

660 Ft. from E. Line

 Ft. from W. Line

Pratt County

Location _____

Rig up _____

Drilling and Remarks:

CR 84326
5" 04459

RECORD

Cased _____ in., _____ ft.

Sand _____

Gas _____

Oil _____

Total Depth 4460

PRODUCTION

1st 24 hrs. Nat. _____

1st 24 hrs. after shot _____

Gas _____ Cu. Ft.

Dry Hole _____

Abandoned _____

Date

DEC 1 9 1945 19

S. J. LEWIS Scout