

Pratt


FORM 51 5M 6-46 PETROL

KANSAS

Section 24 Township 29 Range 14W

Well No. 3 Andrews "B"

Company Lion Oil

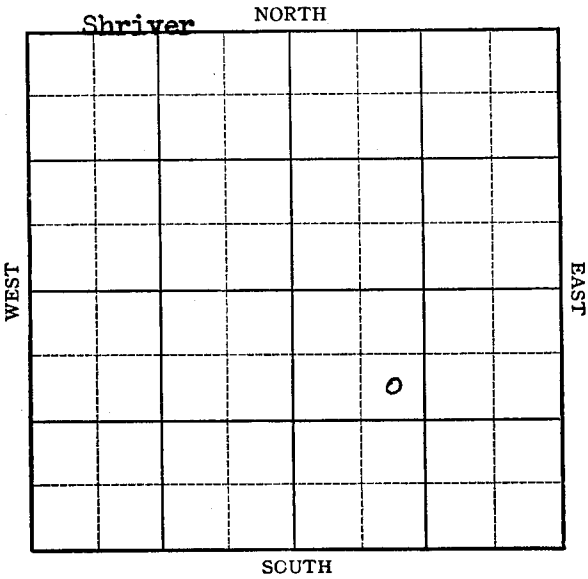

KANSAS

pratt county ✓

Sec. 24 Twp. 29 R. 14W X

Well No. 3 Andrews "B" Farm

Lion Oil Company

Shriver Pool

990

Ft. from N. Line


Ft. from S. Line

Ft. from E. Line

990

Ft. from W. Line

SE NW SE

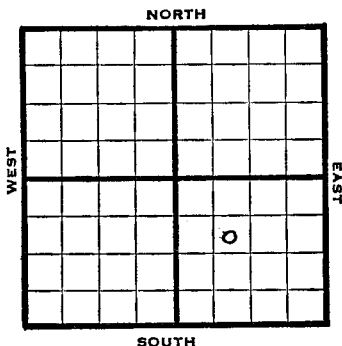

1947 Elev. 1956' REPORT

1/7	8" @ 438 Drlg. 2079'
5/13	Drlg 3545'
5/20	Lans 3874 Drlg 3878'
5/27	Lansing 3871 Core test Pump 4323 Arbuckle 4338 TD 4444 5" @ 4443 RUST
6/3	24 shots 4387-85 500 acid
6/10	" "

OVER

6/18

Arb. 4338'

5" @ 4443'

Perf.

500 Acid

Pump 105 Oil $\frac{1}{2}$ 70% W Pot

39.9 Gr.

TD 4444'

COMPLETED

Map No. K92 Sec. 24 Twp. 29 R. 14W


Well No. 3 Andrews "B"

Lion Oil Company

FIRST REPORT Contractor

SE NW SE

SECTION PLAT

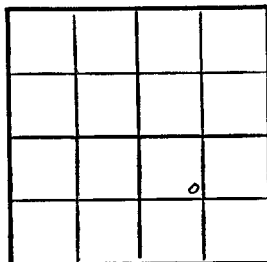

990 Ft. from N. Line

 Ft. from S. Line

 Ft. from E. Line

990 Ft. from W. Line

Pratt County

Location

Rig up

Drilling and Remarks:

8" @ 438

drlg. 2079

RECORD

Cased in. ft.

Sand

Gas

Oil

Total Depth

PRODUCTION

1st 24 hrs. Nat.

1st 24 hrs. after shot

Gas Cu. Ft.

Dry Hole

Abandoned

Date

MAY 24 1947 19

S. J. LEWIS Scout

Map No. 92 Sec. 24 Twp. 29 R. 14W

Well No. 3 Andrews "B"

Lion Oil Company

COMPLETE

Contractor

SE NW SE


E 1, 1956
SECTION PLAT

990 Ft. from N. Line

_____ Ft. from S. Line

_____ Ft. from E. Line

990 Ft. from W. Line

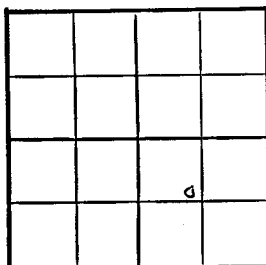

Pratt County

Location _____

Rig up _____

Drilling and Remarks:

CR 87338

5' to 443

Perf.

53000000

Prod 105 oil

750 to NW 24

RECORD

Cased _____ in., _____ ft.

Sand _____

Gas _____

Oil _____

Total Depth 4444

PRODUCTION

1st 24 hrs. Nat. _____

1st 24 hrs. after shot _____

Gas _____ Cu. Ft.

Dry Hole _____

Abandoned _____

Date

JUN 18 1947

19

S. J. LEWIS

Scout