
Sedgwick KANSAS

SECTION 24 TOWNSHIP 29 RANGE 1W

WELL NO. #1 Callaway

COMPANY Geo. P. Vye

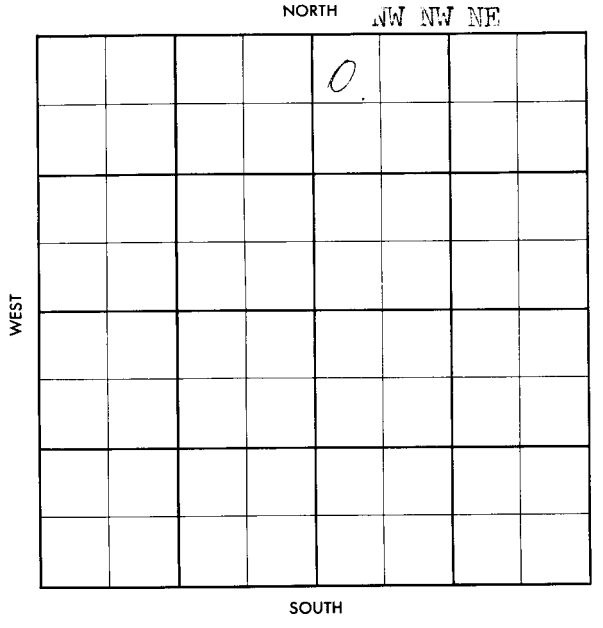

FORM 513 SUNRAY

County Sedgwick Elev.

Sec. 24 Twp. 29 Rge. 1W

Company Geo. P. Vye

Farm Name Calloway No. 1

TOPS	DEPTH	LOG	DATUM
Anh.			
Tp.			
H.			
Tr.			
Dg.			
Bl.			
L.			
K.C.			
B.K.C.			
Ce.			
C.			
M.			
M.			
K.			
Mz.			
Me.			
V.			
S.			
S.			
A			
R.			
PE.			
G.			
TD			

Loc. in Sec. NW NW NE

Geol.

Contr. Prime Drlg.

Pool Brumley

JAN 30 '57

FIRST REPORT

Date Comm. 1-26-57 San - FO

8" @ 286/250 drlg. 1190

24

R19W to Stafford

FORM 513 SUNRAY

County Sedgwick Elev. 1278 Co.

Sec. 24 Twp. 29 Rge. 1W

Company Geo. P. Vye

Farm Name Callaway No. 1

TOPS	DEPTH	LOG	DATUM
Anh.			
Tp.			
H.			
Tr.			
Dg.			
Bl.			
L.	2772		
K.C.			
B.K.C.			
Ce.			
C.			
M. Chert	3324		
M. Dolo	3356		
K.			
Mz.			
Mo.			
V.			
S.			
S.			
A			
R.			
P€.			
G.			
T.D.	3362		

Loc. in Sec. NW NW NE

Geol.

Contr. Prime Drlg. #2

Pool Brumley

Lse.

MAR 3 '57

COMPLETE

No.

Date Comm. 1-26-57 Sun - FO

Sec.

8" @ 286/250 drlg. 1190 FEB 6 '57

T.

Lsg 2772 Miss Chert 3324 crd

3332-44 ss 9½' crd @ 3345'

-62 ss 1' sh 6' slightly dolo. Lime

bleeding oil 5' Lime 5' Limey Dolo

Rag pipe FEB 13 '57 5½ @ 3359/100

R.

MICT Co FEB 20 '57 CO 3362 FO 1050'

Fluid 70 % wtr $ 1 6/10 BFPH 70%

wtr 4 hrs PB 3361 12/ 3356-59

FORM 513-I SUNRAY

1/2 in 8. 5 Bopd + 10 BWPH
12 hrs T.E.R FEB 27 '57 X MAR 6 '57
P. 25 Bopd + 70 BWPD
MAR 7 '57 P 30 BO + 60 BW /24