


SECTION 24 TOWNSHIP 29 RANGE 2 W

WELL NO. #1 Chambers

COMPANY Shawver-Armour et al

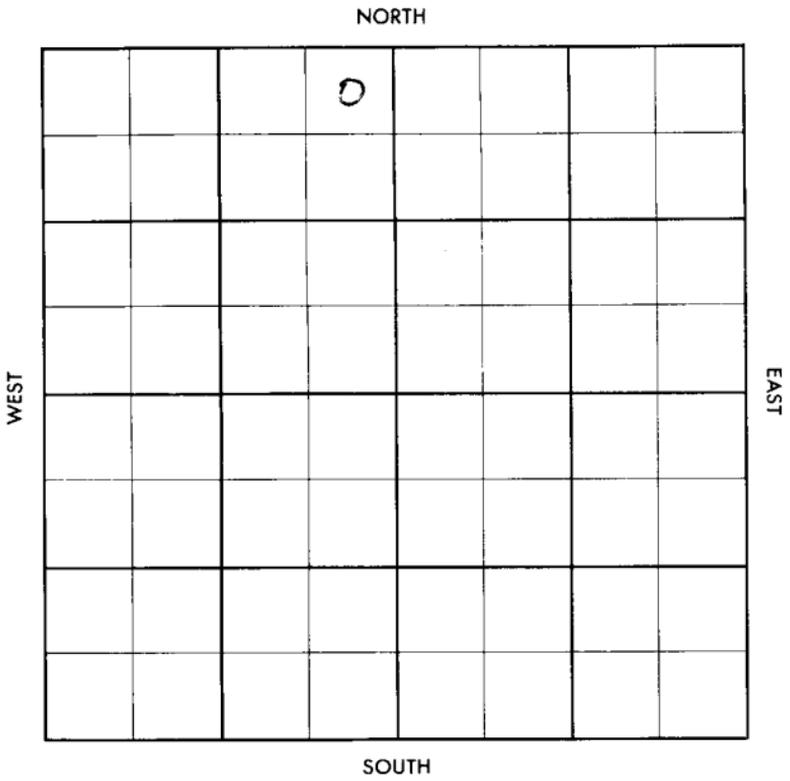

Sedgwick

KANSAS

SEC. 24	TWP. 29	R. 2W
------------	------------	----------

WELL NO. #1 Chambers FARM

COMPANY Shawver- Armour etal

CONTRACTOR

Chambers Ext.


_____ Ft. from N. Line

_____ Ft. from S. Line

_____ Ft. from E. Line

_____ Ft. from W. Line

NE NE NW

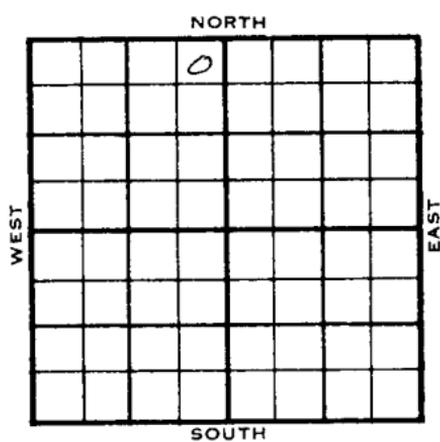

Appleman, Aurora & NCRA, Supp

1955	ELEVATION 1291'	REPORT
------	--------------------	--------

11-23	Comm. 11-17-55 8" @ 365/245 Drlg. 2150	(Miss test)
11-30	D & A K.C. 2965 M. 3603 T.D. 3652'	

ABANDONED

County **Sedgewick** Elev. **1291**

Sec. **24** Twp. **29** Rge. **2W**

Company **Shawver - Armour et al.**

Farm Name **Chambers** No. **1**

TOPS	DEPTH	LOG	DATUM
Anh.			
Tp.			
H.			
Tr.			
Dg.			
Bl.			
L.			
K.C.			
B.K.C.			
Ce.			
C.			
M.			
M.			
K.			
Mz.			
Mo.			
V.			
S.			
S.			
A.			
R.			
Pe.			
G.			
T.D.			

Loc. in Sec. **NE NE NW**
Miss test
 Geol. _____
 Contr. _____
 Pool _____
Chambers Ext.

NOV 23 1955
FIRST REPORT

ate Comm. **Applesman, Aurora & NCRA - support**
11-17-55 8" @ 365/245 drlg. 2150

~~28~~

County Sedgewick Elev. 1291
 Sec. 24 Twp. 29 Rgs. 2W
 Company Shawver - Armour et al.
 Farm Name Chambers No. 1

Co.

TOPS	DEPTH	LOG	DATUM
Anh.			
TP.			
H.			
Tr.			
Dg.			
Bl.			
L.			
K.C.	<u>2965</u>		<u>1674</u>
B.K.C.			
Ce.			
C.			
M.	<u>3603</u>		<u>2312</u>
M.			
K.			
Mz.			
Me.			
V.			
S.			
S.			
A.			
R.			
PE.			
G.			
T.D.	<u>3652</u>		

Loc. in Sec. NTW NW 10W
 Geol. _____
 Contr. _____
 Pool Chambers Ext.

Lse.



No.

Date Comm. 11-17-55
8" @ 365/215

NOV 30 1955

D & A

Sec.

T.

R.