


Section 24 Township 29 Range 37W

Well No. #1 Carter

Company Hugoton Prod.

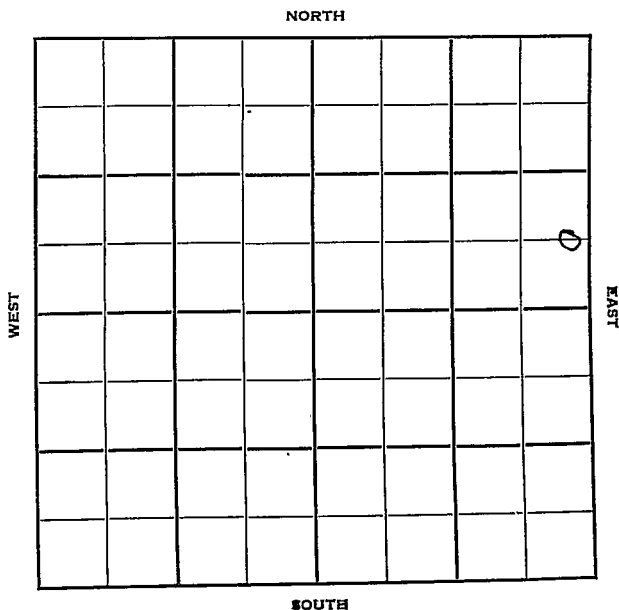

Grant

KANICAL ✓

Sec. 24 Twp. 29 R. 37W

Well No. #1 Carter Farm

Hugoton Prod. Company


Contractor

1960' Ft. from N. Line

Ft. from S. Line

200' Ft. from E. Line

Ft. from W. Line

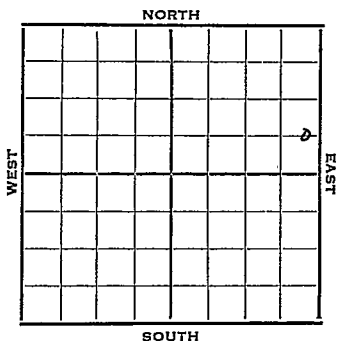

C E L S E N E

1952 Elev. 2998' REPORT

5/7 Spud 5-1-52
10" @ 501
Drlg. 2365'

5/14 RTD 2415' 7" @ 2405' DP 3000 A
@ 2487' Drlg. 2532'

5/21 TD 2635 239' of 5½" liner
Hol 2347 Her 2401
Kri 2420 Winfield 2486
Up Ft. 2545 Low Ft. 2596

5/28 NR

6/11 "

6/18 "


6/25 "

7/2 14,000 A

7/9 NR

7/16 Spud 5-1-52 Gas Well TD 2635
10" @ 501 7" @ 2405 TD 2415
DD 2635 Hol. 2347 Her. 2401
Kri 2420 Win. 2486
Ft. Riley 2545 16,000 A
Comp. 21,801,000 gas 400#

COMPLETED

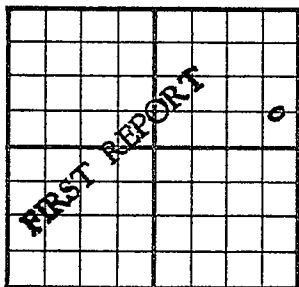County Grant State KansasSec. 24 (Blk. Twp.) 29 (Sur. Rge.) 37W Map No.Operator Hugoton Prod.Well No. 1 Farm CarterElev. Location CEL. SE NE

1960 Ft. From N Line NE
 200 Ft. From E Line Quarter


Ist. Report MAY 7 1952

Completion

Remarks

Spudding Date 5-1-52Drlg. Data
10" @ 501 Drlg. 2365

J. G. McGEHEE

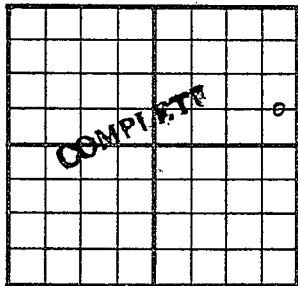County _____ Grant _____ State KansasSec. 24 (Blk. 29 (Sur. 37W Map No. _____
(Twp.) (Rge.)Operator Hugoton Prod.Well No. 1 Farm CarterElev. 2998 Location C E L S E N E1960 Ft. From N Line NE200 Ft. From E Line Quarter

1st. Report _____

Completion JUL 16 1952

Remarks _____

Spudding Date 5-1-52Drlg. Data Gas well TD 263510" @ 501 7" @ 2405 TD 2415 DD 2635Hol. 2347 Her. 2401 Kri. 2420Win. 2486 Ft. Riley 2545 16000 AComp. 21,801,000 gas 400#

J. G. McGEHEE