

*Now* ~~back~~

KANSAS

25

~~19~~

18W

29

SECTION \_\_\_\_\_ TOWNSHIP \_\_\_\_\_ RANGE \_\_\_\_\_

#1 Jenkins

WELL NO. \_\_\_\_\_

Imperial Oil Co.


COMPANY \_\_\_\_\_

NORTH

C NE NW

WEST

EAST

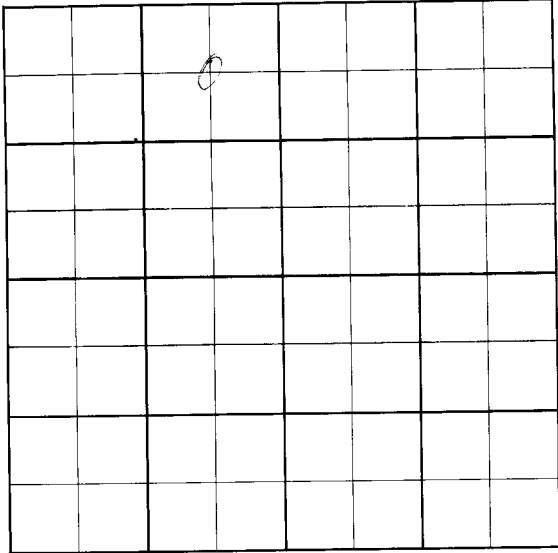

SOUTH

Kiowa

SEC. 25	TWP. 29 -19 S	R. 18 W
------------	---------------------	------------

WELL NO. #1 Jenkins FARM

COMPANY Imperial Oil Co.

CONTRACTOR Patton Tools


Wildcat

\_\_\_\_\_ FT. FROM N. LINE

\_\_\_\_\_ FT. FROM S. LINE

\_\_\_\_\_ FT. FROM E. LINE

\_\_\_\_\_ FT. FROM W. LINE

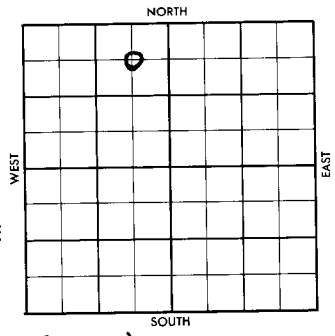

C NE NW

SDX-1 Mile Pure-(Ac Cont. & DHM)

1957	ELEVATION	REPORT
------	-----------	--------

3/27	Location	(FR Tkt)
------	----------	----------

Rush Co.

# WILDCAT

FORM 513 SUNRAY

County ~~Wagon~~ **RUSH** Elev. \_\_\_\_\_  
 Sec. **25** Twp. **19** Rge. **18W**  
 Company **Imperial Oil Co.**  
 Farm Name **Jenkins** No. **1**

TOPS	DEPTH	LOG	DATUM	Loc. in Sec.
Anh.				<b>C NE NW</b>
Tp.				
H.				
Tr.				
Dg.				
Bl.				
L.				Geol. _____
K.C.				Contr. _____
B.K.C.				<b>Patton Tools</b>
Ce.				Pool _____
C.				<b>Wildcat</b>
M.				
M.				
K.				
Nz.				
Me.				
V.				
S.				
S.				
A.				
R.				
PE.				
G.				
TD				

SDX-

**FIRST REPORT**  
 1 mile  
 MAR 27 '57

Date Comm. **Pure (Ac Cont. & DHM)**  
 Location \_\_\_\_\_

*[Handwritten signature]*



County Iowa Elev. 2148  
 Sec. 25 Twp. 29 Rge. 18W  
 Company Imperial Oil Co.  
 Farm Name J. King No. 1

	DEPTH	LOG	DATUM	Loc. in Sec.
	550			C NE NW
	2100			
Tr.	40	4222		
Dg.	TC	4087		
Bl.	D9	4125		
L.		4262		
K.C.				Geol.
B.K.C.				Entr.
Ce.				
C.				Broken Tools
M.	4864			Pool <u>NICHOLS</u>
M.	61	4959		W. cat
K.				
Mz.				
Mo.				
V.				
S.				
S.				
A.				
R.				
PE.				
G.				
TD	4975			

**ABANDONED**

1 Mile  
MAY 8 '57

Date Comm. Pure (Ac Cont & DHM)  
 Location APR 2 '57 Mag. F.O. APR 10 '57  
MIRT 4-9-57 8578  
482/500 D 2530 APR 24 '57 1109110  
MAY 1 '57 crd 4866-81 rec 15' 5519  
chert DST 4868-84 1hr 12'  
Md BHP 124/20" crg @ 4884  
MAY 8 '57 core jammed DST 4890  
-96 2 hrs rec 160' 50' 6 CM  
+180' 0' 6 CM BHP 1615

2000

DST 4894-4905 2 hrs see  
1260' SW + 60' MW B.H.P.  
1683

P&A

crd 4881-96 see 15' chert + ss o  
" 4896-97 1/2 Barreled Jamm  
" 4898-4900 1/2 " "  
see 1 1/2" chert + ss o

This well was first reported in Section 25, Twp. 19, Rge. 18W, Kiowa County. We returned it to you and you said to change it to Rush County. The completion ticket came in as Section 25, Twp. 29, Rge. 18W, Kiowa County. Please check Section, Twp. & Rge. and county, and advise us which is correct.

Thank you,

Sam Baird

Sec. 25-29S-18W, Kiowa County is correct.