


Pratt

Section AS25 Township 29 Range 14W

Well No. #1 Allen

Company Lion Oil Ref.

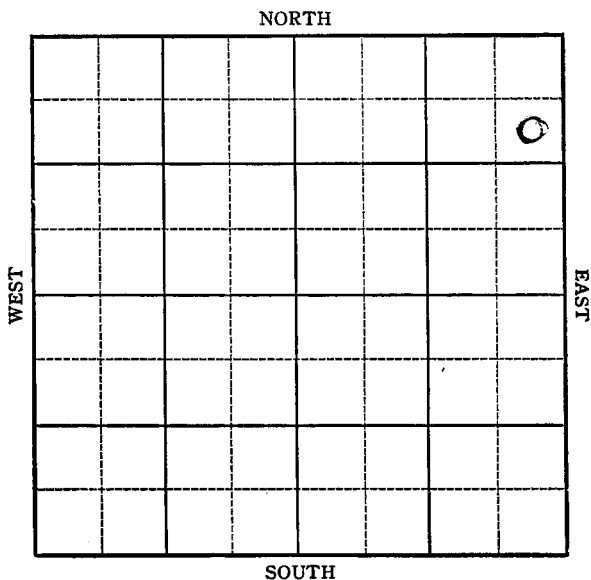

KANSAS

Pratt

Sec. 25 Twp. 29 R. 14W

Well No. #1 Allen Farm

Lion Oil Ref. Company


990 Ft. from N. Line

 Ft. from S. Line

330 Ft. from E. Line

 Ft. from W. Line

ele. 1950

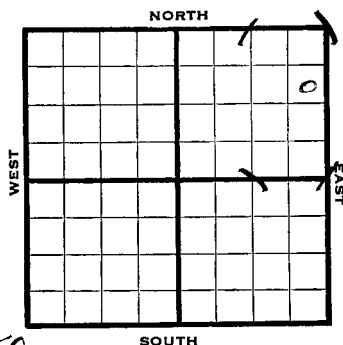

1944

REPORT

4/19	Location
4/26	"
5/3	"
5/10	"
5/17	Derrick
5/24	8" @ 500 WOC
5/31	Drlg. 2500
6/7	Drlg. 4080
6/21	Aps. 4746 Viola 4593 Simp 4631 I.D. 4735

ABANDONED

KANSAS

Pool Name NOMap No. 92 Sec. 25 Twp. 29 R. 14WWell No. 1 AllenLion Oil Ref.


Company

FIRST REPORT

Contractor

SE NE NE

SECTION PLAT

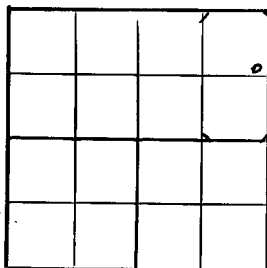990 Ft. from N. Line Ft. from S. Line330 Ft. from E. Line Ft. from W. LinePratt CountyLocation XRig up

Drilling and Remarks:

RECORD

Cased in., ft.Sand Gas Oil Total Depth

PRODUCTION

1st 24 hrs. Nat. 1st 24 hrs. after shot Gas Cu. Ft.Dry Hole Abandoned

Date

APR 19 194419S. J. LEWIS

Scout

KANSAS

Pool Name NOMap No. 92 Sec. 25 Twp. 29 R. 14WWell No. 1 AllenLion Oil Ref.


Company

ABANDONED

Contractor

SE NE NE

SECTION PLAT

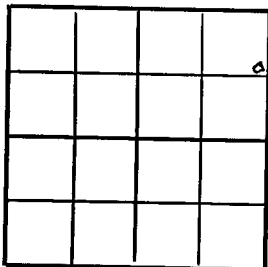990 Ft. from N. Line Ft. from S. Line330 Ft. from E. Line Ft. from W. LinePratt CountyLocation Rig up

Drilling and Remarks:

Cor & 4746
Vid 4583
Imp Sol 4681

RECORD

Cased in., ft.Sand Gas Oil Total Depth 4785

PRODUCTION

1st 24 hrs. Nat. 1st 24 hrs. after shot Gas Cu. Ft.Dry Hole Abandoned

Date

JUN 21 194419S. J. LEWIS Scout