

KANSAS


Grant

Form 51-5M 5-37 Petrol

Section 25 Township 29 Range 35-W

Well No. #1 Cummings

Company United Producing

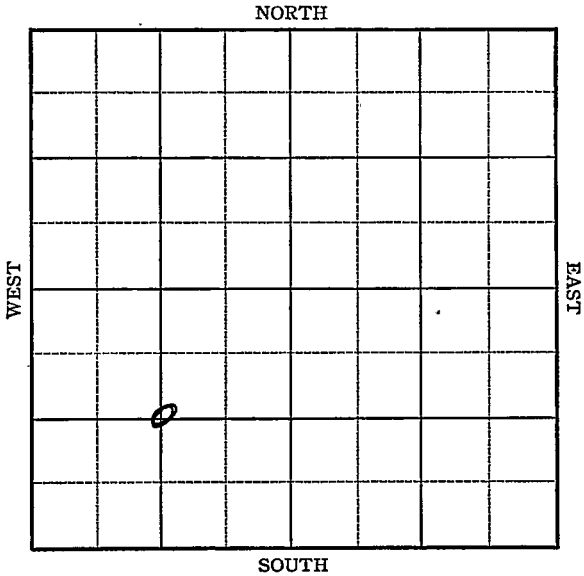

1938

1/12 7" @ 2528'.

T.D. 2717'.

2 M gas.

80 qts. 2675-2707'.

40 qts. 2585-2605'.

3,380,000 gas.

COMPLETED

KANSAS

Grant

Map No. _____ Sec. 25 Twp. 29 R. 35WWell No. 1 CummingsUnited Producing Company


Contractor

FIRST REPORT**C SW**

_____ Ft. from N. Line

1320 Ft. from S. Line

_____ Ft. from E. Line

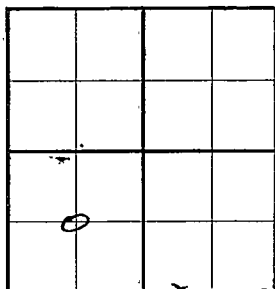1320 Ft. from W. Line**SECTION PLAT**Location X

Rig up _____

Drilling and Remarks:

RECORD

Cased _____ in., _____ ft.

Sand _____

Gas _____

Oil _____

Total Depth _____

PRODUCTION

1st 24 hrs. Nat. _____

1st 24 hrs. after shot _____

Gas _____ Cu. Ft.

Dry Hole _____

~~Abandoned~~ _____

Date

OCT 20 1937H. D. Hatfield Scout

Returned _____

Cards _____

Tracing _____

France Map _____

Scarborough Map _____

Moody Map _____

Scarborough Plat Book _____

Moody F + Book _____

Grant **KANSAS**Map No. No Map Sec. 25 Twp. 29 R. 35WWell No. 1 CummingsUnited Producing Company

Contractor

COMPLETED

C/SW

 Ft. from N. Line1320 Ft. from S. Line Ft. from E. Line1320 Ft. from W. Line

SECTION PLAT

Location Rig up

Drilling and Remarks:

2 M gas
80 gts 2675-2707
40 gts 2585-2605
3,380,000 gas

RECORD

Cased 7 in., 2528 ft.Sand Gas Oil Total Depth 2717


PRODUCTION

1st 24 hrs. Nat. 1st 24 hrs. after shot Gas Cu. Ft.Dry Hole Abandoned

Date

JAN 12 1938H. D. Hatfield

Scout

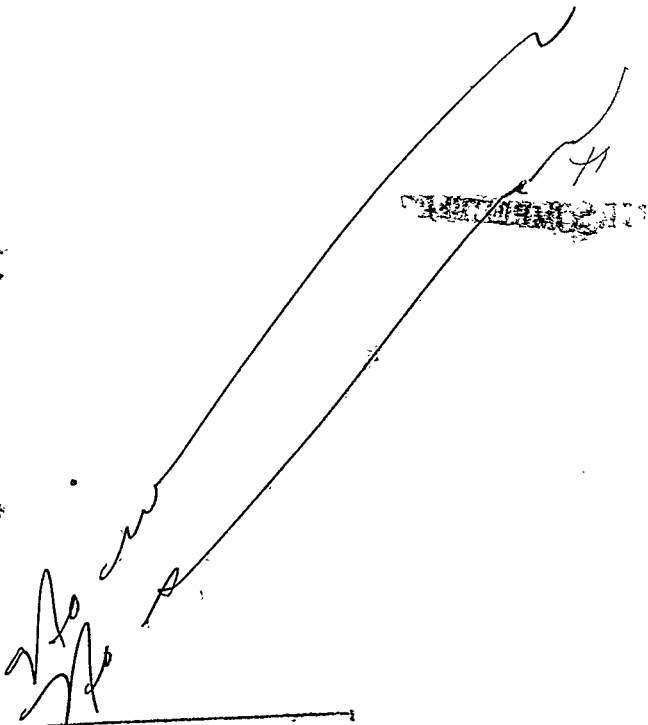

Returned	_____
Cards	_____ <i>Paul</i>
Tracing	_____ <i>✓</i>
France Map	_____ <i>✓</i>
Scarborough Map	_____ <i>X</i>
Moody Map	_____ <i>✓</i>
Scarborough Plat Book	_____
Moody Plat Book	_____