


Section 25 Township 29 Range 32W
Well No. 1 McClure
Company Petr., Inc.

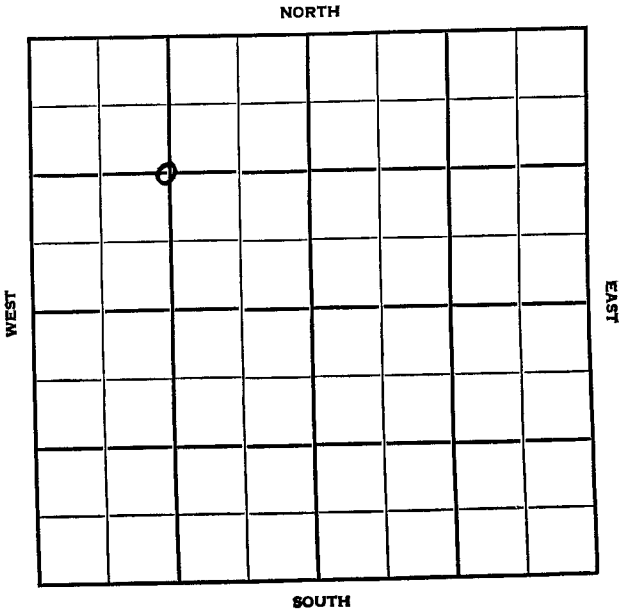

Haskell KANSAS

SEC.	TWP.	R.
25	29	32 W

WELL NO.

1 McClure

FARM

COMPANY

Petroleu, Inc.

CONTRACTOR

Garvey


Hugoton Pool

1320 Ft. from N. Line

Ft. from S. Line

Ft. from E. Line

1320 Ft. from W. Line

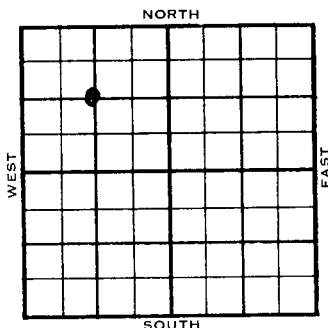

C NW/4

CSO - FO

	ELEVATION	REPORT
1954	2892'	

11/3 Spud 10-30-54
8" @ 511'
rlg. 2265'

12/15 Spud 10-30-54 Gas well TD 2729
8" @ 511 TD 2 699 5" @ 2698 1500 A
220,000 CFG DD 2729 A-frac.
SI 24 hrs. 1,400,000 CFG 390+
1000 A Comp. 2,203,000 CFGPD 411#


COMPLETED

County **Haskell** State **Kansas**
 Sec. **25** (Blk. **29** (Sur. **32W** Map No.

Operator **Petroleum Inc.**

Well No. **1** Farm **McClure**

Elev. Location **C NW/4**

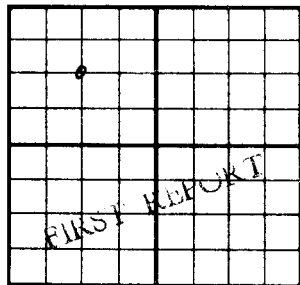

1320 Ft. From **N** Line **NW**

1320 Ft. From **W** Line Quarter

Ist. Report **NOV 3 1954**

Completion

Remarks **CSO - FO**


Garvey - Contr.

Spudding Date **10-30-54**

Drlg. Data **Hugoton Pool**

8" @ 511 drlg. 2265

FABER - LOSTRAP

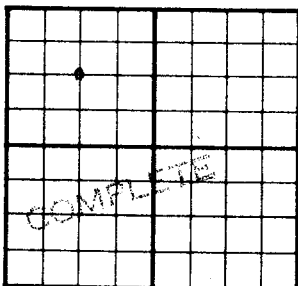County Haskell State KanSec. 25 (Blk. Twp.) 29 (Sur. Rge.) 32W Map No.Operator Petroleum Inc.Well No. 1 Farm McClureElev. 2892 Location C NW/41320 Ft. From N Line NW1320 Ft. From W Line Quarter

1st. Report

Completion DEC 15 1954Remarks Hugoton PoolGarvey - Contr.Spudding Date 10-30-54Drilg. Data Gas well TD 27298" @ 511 TD 2699 5" @ 2698 1500 A220,000 cfg DD 2729 A-fracSI 24 hr. 1,400,000 cfg 390# 1000 AComp. 2,903,000 cfgpd 411#