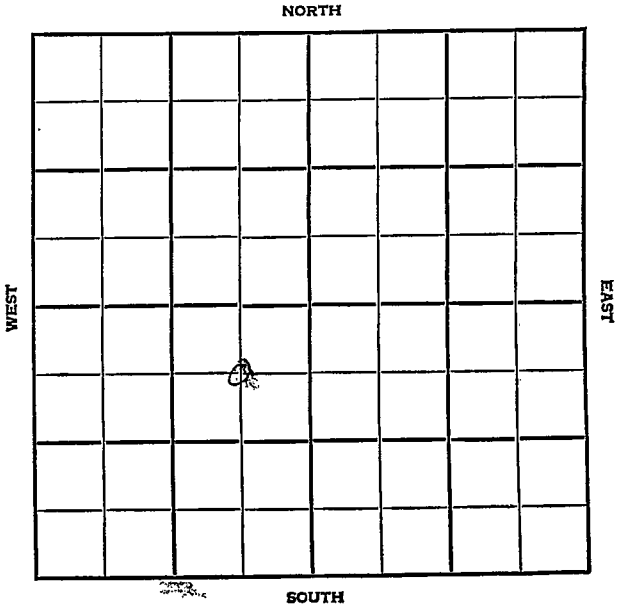


Section 25 Township 29 Range 34 WWell No. #2 Elliot "A"Company Helmerich & Payne

Haskell

KANSAS

SEC.	TWP.	R.
25	29	34W

WELL NO.

#2 Elliot "A"

FARM

COMPANY

Helmerich & Payne

CONTRACTOR

Michaelis

Hugoton


_____ Ft. from N. Line

_____ Ft. from S. Line

_____ Ft. from E. Line

_____ Ft. from W. Line

C NE SW

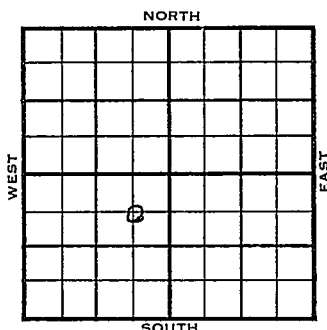

1955	ELEVATION	REPORT
	2966	

10/12

Comm 10-8-55
 10" @ 703/500
 Drlg ~~2532~~ 2520

12-7

5 $\frac{1}{2}$ " @ 2736/800
 CO to 2700 ,frac, 2500 mcfg, SP 2710
 84/ 2684-98, 500 A, 1750 mcfg
 CO to 2700, 10 mcfg, 72/ 2598-2610
 3000 A, 132/ 2625-47, 1000 A, frac
 3500 A,
 Comp. 9100 mcfgpd
 Herr 2586
 Kri 2618
 Wfd. 2664
 U Ft. Riley 2744
 TD 2770'

COMPLETED

County Haskell Elev. 2966
Sec. 25 Twp. 29 Rge. 3/W
Company Helmerich & Payne
FarmName Elliot "A" No. 2

TOPS	DEPTH	LOG	DATUM	Loc. in Sec.
Anh.				C NE SW
Tr.				
H.				
Tr.				
Dg.				
Bl.				
L.				
K.C.				Geol.
B.K.C.				Contr.
Ce.				Michaelis
C.				
M.				Pool
M.				Hugoton
K.				
Mz.				
Mo.				
V.				
S.				
S.				
A.				
R.				
Pe.				
G.				
TR.				

FIRST REPORT
OCT 12 '55

Date Comm. 10-8-55
10" @ 703/500 drlg. 2520

[Handwritten signature/initials]

OCT 13 1955

Scout Cards	<u>MEM</u>
Land Small Map	_____
Land Wall Map	_____
Tracings	_____
France Map	_____
Pierce Map	_____
Misc.	_____

County Haskell Elev. 2966
 Sec. 25 Twp. 29 Rge. 34W
 Company Helmerich & Payne
 Farm Name Elliot "A" No. 2

TOPS	DEPTH	LOG	DATUM
------	-------	-----	-------

Anh.			
Tp.	<u>Herr</u>	<u>2586</u>	
H.	<u>Kri</u>	<u>2618</u>	
Tr.	<u>Wfd</u>	<u>2664</u>	
Dg.	<u>0 Ft Rly</u>	<u>2744</u>	
BL.			
L.			
K.C.			
B.K.C.			
Ce.			
C.			
M.			
M.			
K.			
Mz.			
Mo.			
V.			
S.			
S.			
A.			
R.			
PE.			
G.			
T.D.	<u>2770</u>		

Loc. in Sec. C NE SWGeol. MichaelisContr. HugotonPool DEC 7 1955

COMPLETED

Date Comm. 10-8-5510" @ 703/500 5 1/2" @ 2736/800CO to 2770 frac 2,500 mcfg SP 271084/ 2684-98 500 A 1,750 mcfgCO to 2770 10 mcfg 72/ 2598-26103000 A 132/ 2625-47 1000 A frac3500 A Comp. 9,100 mcfgpd

DEC 15 1955

R. G.