


Section 25 Township 29 Range 39WWell No. 1 WilliamsCompany Western Natural Gas

NORTH

WEST

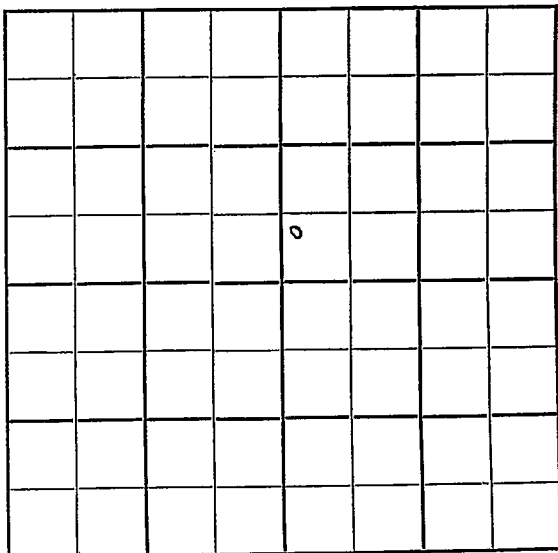

EAST

SOUTH

Stanton

KANSAS

Sec. 25 Twp. 29 R. 39W

Well No. #1 Williams Farm

Western Natural Gas Company

Contractor


Ft. from N. Line

440' Ft. from S. Line

Ft. from E. Line

250' Ft. from W. Line

SW NE

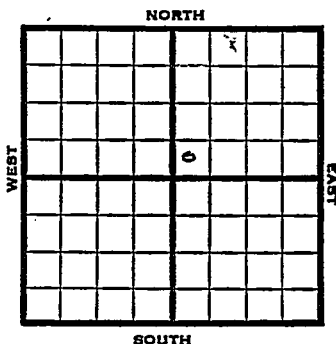

1951 Elev. 3123 REPORT

8/1 Spud 7-30-51

10" @ 530'

WOC

9/12 Spud 7-30-51

Gas Well TD 2504

10" @ 530 " @ 2289

TD 2504

Her. 2284 Win. 2348

Ft. Riley 2418

Comp. 13,700,000 gas 393#

COMPLETED

County **Stanton** State **Kansas**

Sec. 25 (Blk. Twp.) 29 (Sur. Rge.) 39W Map No.

Operator **Western Natural Gas**

Well No. **1** Farm **Williams**

[illegible]

0

~~FIRST REPORT~~

440 Ft. From S Line NE

250 Ft. From W Line Quarter

1st. Report AUG 1 1951

Completion

Remarks

Spudding Date **7-30-51**

Drig. Data

10¹¹ @ 530 WOC

County Stanton State Kansas
 Sec. 25 (Blk. 29 (Sur. 39W Map No.
 (Twp.) (Rge.)
 Operator Western Natural Gas
 Well No. 1 Farm Williams
 Elev. 3123 Location SW NE

			0				

COMPLETE

440 Ft. From S Line NE
250 Ft. From W Line Quarter

1st. Report

Completion SEP 12 1951

Remarks

Spudding Date 7-30-51

Drilg. Data Gas well TD 2504

10" @ 530 7" @ 2289 TD 2504

Her. 2284 Win. 2348 Ft. Riley 2418

Comp. 13,700,000 gas 393#

J. E. TYRA