


Section 26 Township 29 Range 32W

Well No. 1 McClure "B"

Company Cities Service

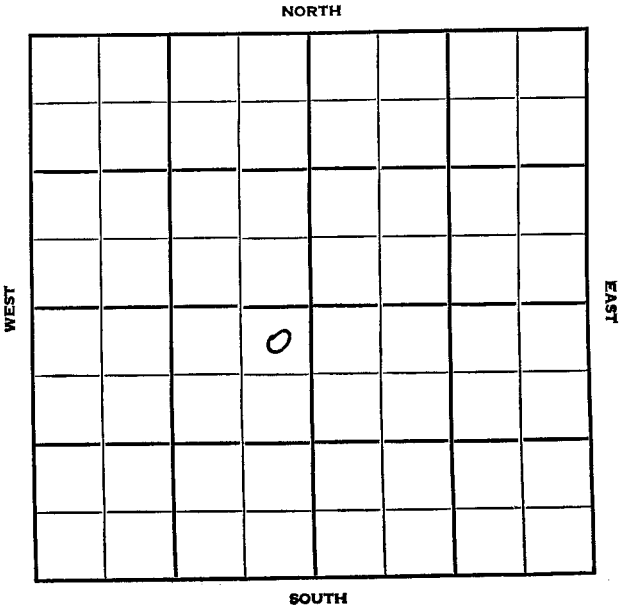

Haskell KANSAS

SEC.	TWP.	R.
26	29	32W

WELL NO.

1 McClure "B"

FARM

COMPANY

Cities Service

CONTRACTOR

Hugoton Pool

100


Ft. from N. Line

Ft. from S. Line

100

Ft. from E. Line

Ft. from W. Line

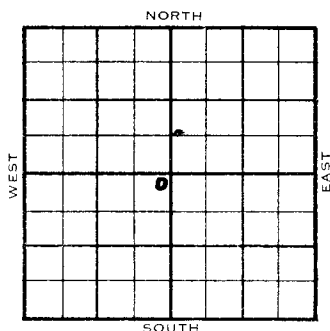

NE NE SW

1954

ELEVATION

2894

REPORT

6/23

Spud 6-16-54

8" @ 607'

Drlg. 2610'

6/30

RTD 2795

5" @ 2794

8/4

Spdg 6-16-54

Gas well

TD 2795

8" @ 607

Her 2662 Kri. 2684 Win. 2753

TD 2795

5" @ 2794 CO to 2773 60/2754-66

1500 A 340,000 gas 30 gswph CO to

2740 60- 2682-94 120/2706-30 500 A

2 dol-fracs 620-000 cdf A-frac

1,180,000 cfg Comp. 6,400,000 cfgpd

404#

COMPLETED

County **Haskell** State **Kansas**

Sec. **26** (Blk. **29** (Sur. **32W** Map No.

Operator **Cities Service**

Well No. **1** Farm **McClure "B"**

Elev.	Location	NE	NE	SW
-------	----------	----	----	----

[illegible]

100 Ft. From **N** Line **SW**

100 Ft. From E Line Quarter

1st. Report **JUN 23 1954**

Completion


Remarks

Spudding Date 6-16-54

Drig. Data Hugoton Pool

8" @ 607 drlg. 2610

County Haskell State Kansas
 Sec. 26 (Blk. 29) (Sur. 3 2W) Map No.
 Operator Cities Service
 Well No. 1 Farm McClure "B"
 Elev. 2894 Location NE NE SW

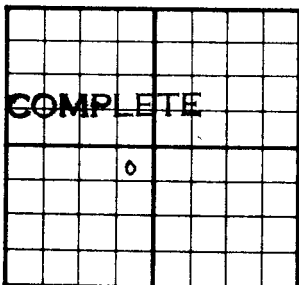

100 Ft. From N Line SW
 100 Ft. From E Line Quarter

1st. Report

Completion AUG 4 1954

Remarks Hugoton Pool

Spudding Date 6-16-54

Drilg. Data Gas well TD 2795

8" C 607 Her. 2662 Kri. 2634

Win. 2753 TD 2795 5" C 2794 CO to 2773

60/ 2754-66 1500 A 340,000 gas

30 gswph CO to 2740 60/ 2682-94

120/ 2706-30 500 A 2 dol-fracs

620,000 cfg A-frac 1,180,000 cfg

Comp. 6,400,000 cfgpd 404#

J. G. McGEHEE