
Kingman KANSAS

SECTION 26 TOWNSHIP 29S RANGE 7W

WELL NO. #2 Krehbiel

COMPANY Drillers Production

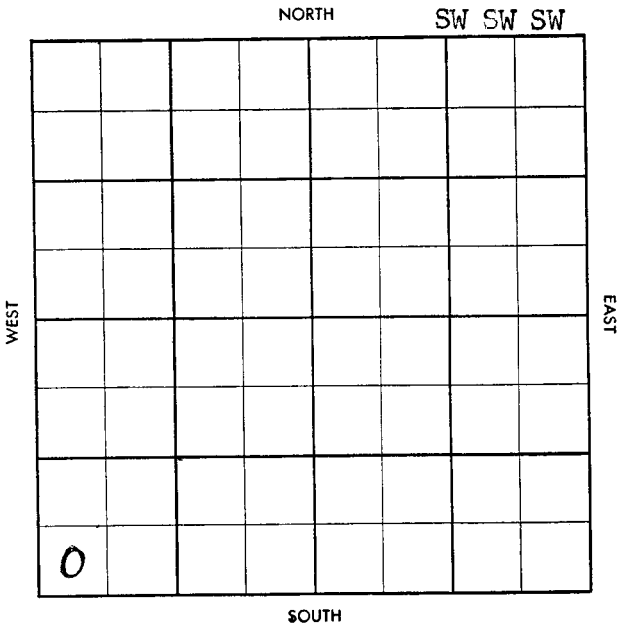

FORM 504-3 SUNRAY

S-513-B

Trenton

County Kingman Elev.

Sec. 26 Twp. 29 Rge. 7W

Company Drillers Production

Farm Name Krehbiel No. 2

TOPS	DEPTH	LOG	DATUM
Anh.			
Tp.			
H.			
Tr.			
Dg.			
B. L.			
L.			
K.C.			
B.K.C.			
Ce.			
C.			
M.			
M.			
K.			
Mz.			
Mq.			
V.			
S.			
S.			
A.			
R.			
Pf.			
G.			
T.D.			

Loc. in Sec. SW SW SW

Geol.

Cont Gabbert-Jones Tools

Pool Trenton

FEB 12 58

FIRST REPORT

Date Comm. 2/7/58

8" @ 265 Drlg. 2063.

Co. Lse. No. Sec. T. R.

Twp. X Pool TRENTON

Co. X Feet X

S-513 B

Co. Kingman Elev. 1526. [redacted]

26 Twp. 29 Rge. 7W

Farm Name Drillers Production

Farm Name Krehbiel No. 2

TOPS	DEPTH	LOG	DATUM
Anh.			
Tp.			
H.	3071		
Tr.			
Dg. Sd	3194		
B. L.			
L.	3299		
K.C.			
B.K.C.	3813		
Ce.			
C.			
M. Chert	4111		
M. Li	4148		
K.			
Mz.			
Mq.			
V.			
S.			
S.			
A.			
R.			
Pf.			
G.			
T.D.	4156		

Loc. in Sec. SW SW SW

Geol.

Cont. Gabbert-Jones Tools

Pool Trenton

COMPLETE

Offset

APR 9 '58

Lse.

No.

Sec.

T.

R.

Date Comm. 2/7/58

8¼" @ 265 Drlg. 2063, FEB 19 '58 Good show in Miss ~~no~~ Log 5½ 4152 FEB [illegible] CO

MAR [illegible] DO + 79 TD 8 17 BO + 3 BW 24 hrs

Frac 10 $ Ld 1$ 8 BO ph + 87 ow

NT T&R POP MAR [illegible] wop MAR 19 58

MAR [illegible] 58 MAR [illegible] 58 Phy P 3300

+ 3070 w

Miss Open Hole