


Kingman

KANSAS

SECTION 26 TOWNSHIP 29S RANGE 7W

WELL NO. #3 Graber

COMPANY Drillers Prod. Co.

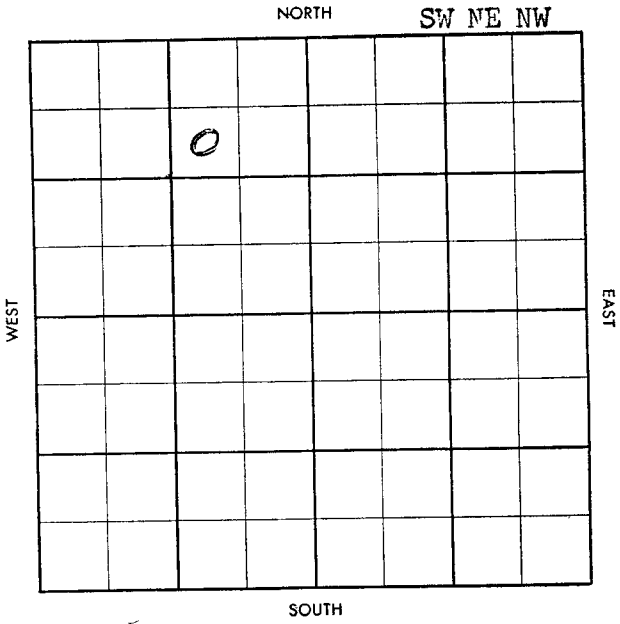



County Kingman Elev. _____
 Sec. 26 Twp. 29 Rge. 7W
 Company Drillers Prod. Co.
 Farm Name Graber No. 3

TOPS	DEPTH	LOG	DATUM
Anh.			
Tp.			
H.			
Tr.			
Dg.			
B.L.			
L.			
K.C.			
B.K.C.			
Ce.			
C.			
M.			
M.			
K.			
Mz.			
Mq.			
V.			
S.			
S.			
A.			
R.			
Pf.			
G.			
T.D.			

Loc. in Sec. SW NE NW
 Geol. _____
 Contr. Gabbert & Jones
 Pool Trenton

FIRST REPORT
 MAY 28 58

Date Comm. 5/26/58 (CSO - FO)

8" @ 274 W/275, WOC


Pool
Foot

S-513-B

County Kingman Elev 1543 DP 1546 MB
 Sec. 26 Twp. 29 Rge. 7th
 Company Drillers Prod. Co.
 Farm Name Graber No. 3

TOPS	DEPTH	LOG	DATUM
Anth.			
Tp.			
H.	<u>3092</u>		
Tr.			
Dg.	<u>sd 3219</u>		
B.L.			
L.	<u>3331</u>		
K.C.			
B.K.C.			
Ce.			
C.			
M.	<u>4126</u>		
M.			
K.			
Mz.			
Mq.			
V.			
S.			
S.			
A.			
R.			
Pf.			
G.			
T.D.	<u>4213</u>		

Loc. in Sec. SW NE NW
 Geol. _____
 Contr. Gabbert & Jones
 Pool Trenton

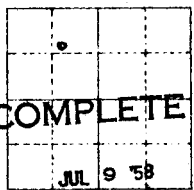

Date Comm. 5/26/58 (850 - 80)
 2" 27 1/2 W/275, 700 JUN 3 '58 @ 3120 JUN 11 '58
5" 4192/100 JUN 18 '58 JUN 25 '58 @ 4213
\$2580 8 BW pd mat free.
40 x 10 \$6 Flo Ld + Flo 2080
ph + 3090w S1 JUL 2 '58 JUL 9 '58
Phy Flo 126 B0 + 3870w pd
Miss 4192 - 4213

No. Sec. T. R.

3'1'13
42'13
1543

1543

3'5''
3'8'2
41'52
2649

1543
1543
1543
1543

2670