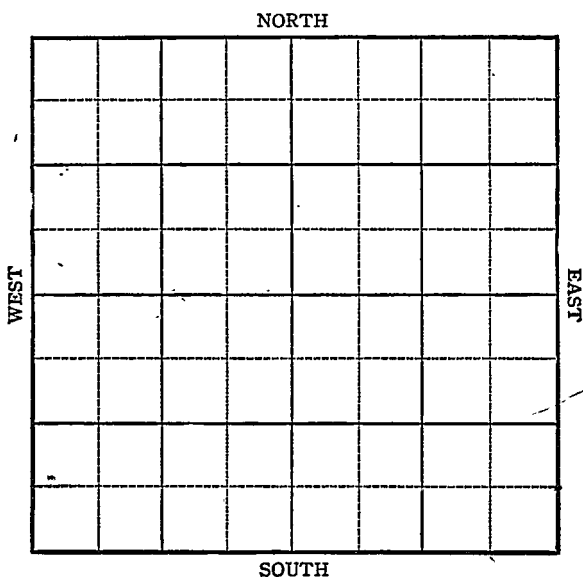


KANSAS

Haskell County

Section 26 Township 29 Range 34Well No. #1 Southwestern
East U.S. CollegeCompany United Prod.

KANSAS Haskell County

Sec. 26 Twp. 29 R. 34W
Well No. #1 ~~Leslie~~ *Southwestern U.S. College* Farm
United Prod. Company

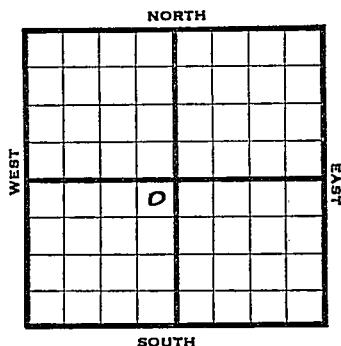
Hugoton

100 Ft. from N. Line

 Ft. from S. Line

100 Ft. from E. Line

 Ft. from W. Line



NE SW

1944

R E P O R T

10/4	Surface Hole
10/11	" "
10/18	10" @ 673'
	7" @ 2535
	TD 2735-229' of 5"
	Perf. liner 6/10 M. gas
10/25	8000 acid
11/1	" "
11/8	" "
11/15	7" @ 2535'
	229' of 5" Perf. liner @ 2735
	TD 2735
	8000 acid
	13,500,000 Gas

COMPLETED

KANSAS Pool Name HugotonMap No. 111 Sec. 26 Twp. 29 R. 34WWell No. 1 LeslieUnited Prod

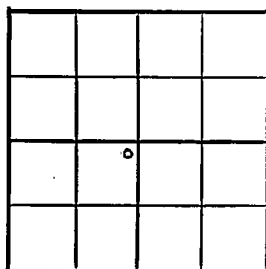
Company

FIRST REPORT

Contractor

NE SW

SECTION PLAT

100 Ft. from N. Line Ft. from S. Line100 Ft. from E. Line Ft. from W. Line

Haskell

Location

Rig up

Drilling and Remarks:
Surface Hole

RECORD

Cased in., ft.

Sand

Gas

Oil

Total Depth

PRODUCTION

1st 24 hrs. Nat. 1st 24 hrs. after shot Gas Cu. Ft.Dry Hole Abandoned

Date

OCT 4 1944 19

S. J. LEWIS

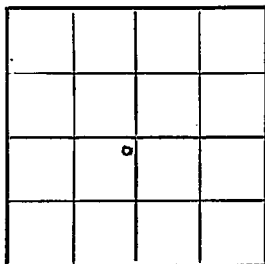
Scout

Pool Name Hugoton
 Map No. N M Sec. 26 Twp. 29 R. 34W
 Well No. 1 U. S. College

United Prod. Company
CORRECTION
 Contractor

NE SW

SECTION PLAT

100 Ft. from N. Line Ft. from S. Line100 Ft. from E. Line Ft. from W. Line**Haskell**Location Rig up

Drilling and Remarks:

Reported as
 #1 Leslie

RECORDCased in., ft.Sand Gas Oil Total Depth **PRODUCTION**1st 24 hrs. Nat. 1st 24 hrs. after shot Gas Cu. Ft.Dry Hole Abandoned

Date

OCT 1 8 1944

19

S. J. LEWIS Scout

Pool Name HugotonMap No. NM Sec. 26 Twp. 29 R. 34WWell No. 1 Southwestern CollegeUnited Prod.

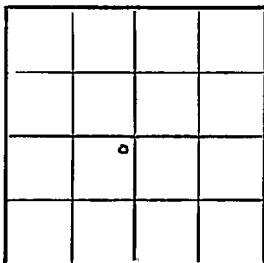
Company

CORRECTION

Contractor

NE SW

SECTION PLAT

100 Ft. from N. Line Ft. from S. Line100 Ft. from E. Line Ft. from W. LineHaskell

RECORD

Location Cased in., ft.Rig up Sand

Drilling and Remarks:

Gas

Reported

Oil U. S. CollegeTotal Depth

PRODUCTION

1st 24 hrs. Nat. 1st 24 hrs. after shot Gas Cu. Ft.Dry Hole Abandoned

Date

OCT 25 1944

19

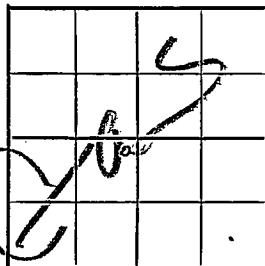
S. J. LEWIS Scout

Pool Name HugotonMap No. VM Sec. 26 Twp. 29 R. 34WWell No. Southwestern CollegeUnited Prod. CompanyCOMPLETED

Contractor

NE SW

SECTION PLAT

100 Ft. from N. Line Ft. from S. Line100 Ft. from E. Line Ft. from W. LineHaskell CountyLocation Rig up

Drilling and Remarks:

7" 20585 229' 24"
5" Perf liner 6275'
8000 acid
13,500,000 Gas

RECORD

Cased in., ft.Sand Gas Oil Total Depth 2235

PRODUCTION

1st 24 hrs. Nat. 1st 24 hrs. after shot Gas Cu. Ft.Dry Hole Abandoned

Date

NOV 15 1944 19S. J. LEWIS Scout