


Section 26 Township 29 Range 39-W

Well No. #1 McIvor

Company Stanolind
Hugoton Pool

NORTH

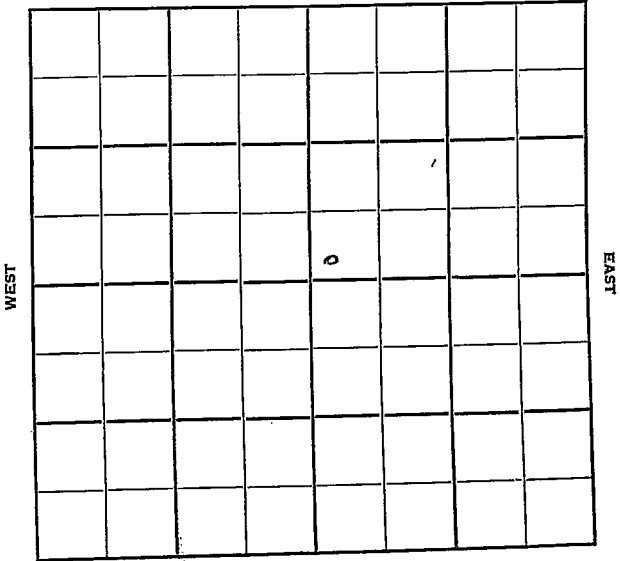

SOUTH

Sec. 26 Twp. 29 R. 39W

Well No. #1 McIvor Farm

Stanolind Company

Noble Drlg. Contractor

Hugoton Pool


 Ft. from N. Line

150' Ft. from S. Line

 Ft. from E. Line

150' Ft. from W. Line

SW NE

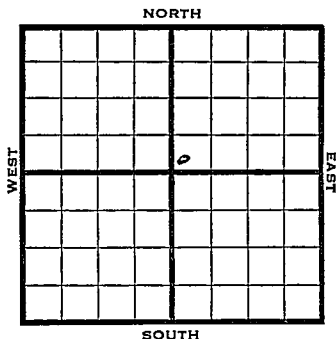

1949 Elev 3182' REPORT

10/26 13" @ 600'
Drlg. 1690'
11/1 TD 2553
7" @ 2502'
11/9 1000 acid
388 shots 2314-2481'
11/16 3000 acid
11/23 "
11/30 TD 2553'
7" @ 2502
Perf
37000 acid
13,178,000 Gas
405# R Pr.
Comp

COMPLETED

Map No. _____ Sec. 26 Twp. 29 R. 39W

Well No. 1 McIvor

Stanolind Company

Noble Drlg. Contractor

SW NE

FIRST REPORT
SECTION PLAT

_____ Ft. from N. Line

150 Ft. from S. Line

_____ Ft. from E. Line

150 Ft. from W. Line

		o	

Stanton County

Location _____

Rig up _____

Drilling and Remarks:

13" @ 600

drlg. 1690

RECORD

Cased _____ in., _____ ft.

Sand _____

Gas _____

Oil _____

Total Depth _____

PRODUCTION

1st 24 hrs. Nat. _____

1st 24 hrs. after shot _____

Gas _____ Cu. Ft.

Dry Hole _____

Abandoned _____

Date

OCT 20 1949 19 S I LEWIS Scout

Map No. _____ Sec. 26 Twp. 29 R. 39W

Well No. 1 McIvor

Stanolind Company

COMPLETE

Contractor

SW NE


F131R
SECTION PLAT

_____ Ft. from N. Line

150 Ft. from S. Line

_____ Ft. from E. Line

150 Ft. from W. Line

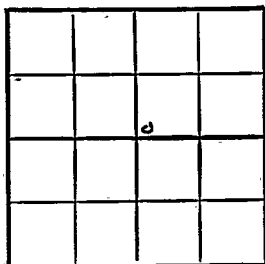

Stanton County

Location _____

Rig up _____

Drilling and Remarks:

7" C2502

Ref.

37000 acid

13,178,000 Gall.

425 R.R.

RECORD

Cased _____ in., _____ ft.

Sand _____

Gas _____

Oil _____

Total Depth 2553

PRODUCTION

1st 24 hrs. Nat. _____

1st 24 hrs. after shot _____

Gas _____ Cu. Ft.

Dry Hole _____

Abandoned _____

Date

NOV 30 1949 19

S. J. LEWIS Scout