


KANSAS

Pratt County

Section 27 Township 29 Range 14W

Well No. #2 Kerr

Company Skelly

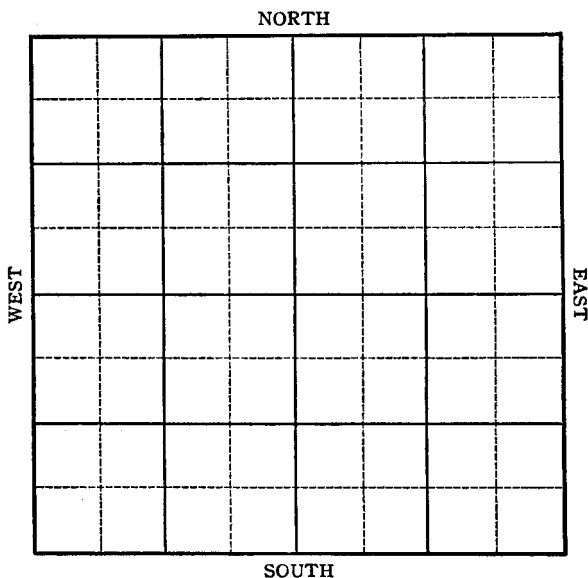

KANSAS

Pratt County

Sec. 27 Twp. 29S R. 14W

Well No. #2, Kerr Farm

Skelly Company

Shriver

 Ft. from N. Line


330 Ft. from S. Line

990 Ft. from E. Line

 Ft. from W. Line

SW SE SW

Elev. 1049

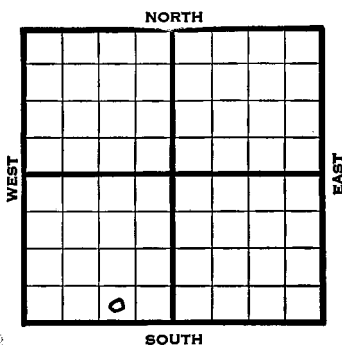

1945

REPORT

4-4 Drilling 300'

1/12 8" @ 763
Drlg. 2105'

/20 Drlg. 3555'

4/27 Lans 3996

Drlg. 4332

5/3 Lans 3993

Viola 4484

Simp 4523

5" @ 4523

TD 4527' RUST

5/10 " " " " "

/17 " " " " "

/24 " " " " "

6/6 Simp 4523

5" @ 4523

TD 4530'

Bomb Pot. 2438'


Grav. 39.9

COMPLETED

Pool Name ShriverMap No. 2 Sec. 27 Twp. 29 R. 14WWell No. 2 KerrSkelly CompanyFIRST REPORT Contractor

SW SE SW

SECTION PLAT

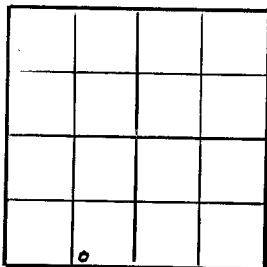 Ft. from N. Line330 Ft. from S. Line990 Ft. from E. Line Ft. from W. LinePratt CountyLocation Rig up

Drilling and Remarks:

300'*Not file*

RECORD

Cased in., ft.Sand Gas Oil Total Depth

PRODUCTION


1st 24 hrs. Nat. 1st 24 hrs. after shot Gas Cu. Ft.Dry Hole Abandoned

Date

APR 4 1945 19 S. J. LEWIS Scout

Kansas Pool Name ShriverMap No. 72 Sec. 27 Twp. 29 R. 14WWell No. 2 KerrSkelly Company**COMPLETED** Contractor

SW SE SW

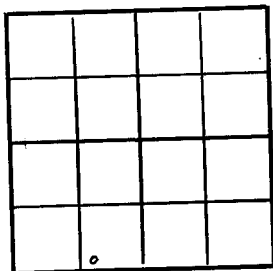E 1, 1849
SECTION PLAT Ft. from N. Line330 Ft. from S. Line990 Ft. from E. Line Ft. from W. LinePratt CountyLocation Rig up

Drilling and Remarks:

Single 45235" @ 4523Bruid P 243539 1/2**RECORD**Cased in., ft.Sand Gas Oil Total Depth 4530**PRODUCTION**1st 24 hrs. Nat. 1st 24 hrs. after shot Gas Cu. Ft.Dry Hole Abandoned

Date

JUN 6 1945 19S. J. LEWIS Scout