


Section 27 Township 29 Range 14-~~17~~

Well No. #3 ~~Kerr~~

Company Skelly

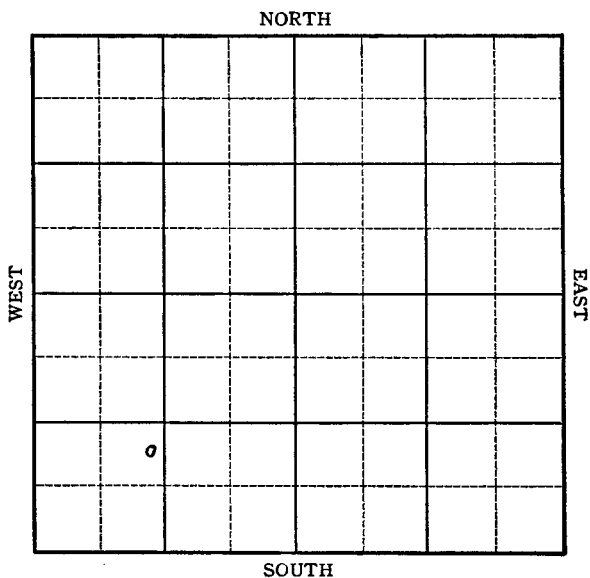

Sec. 27 Twp. 29 R. 14-W

Well No. #3 Kerr Farm


Skelly Company

           Ft. from N. Line

990 Ft. from S. Line

           Ft. from E. Line

1000 Ft. from W. Line

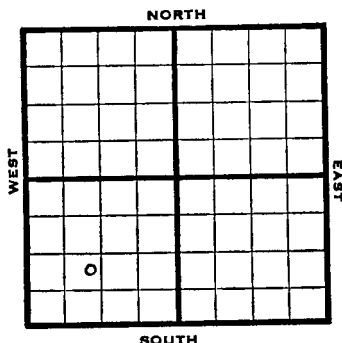

NE SW SW

| REPORT |                                  |
|--------|----------------------------------|
| 1945   | Elev. 1958'                      |
| 12/5   | Derrick                          |
| 12/12  | 8" @ 752 WOC                     |
| 12/20  | Drlg. 3015'                      |
| 12/29  | Lens. 3994' Viola 4486'          |
|        | Simp Sand 4529' T.D. 4530' S.O.  |
|        | 5" - 4529' RUST.                 |
| 1946   |                                  |
| 1/10   | T.D. 4539' Flow 130 oil 6 hours. |
| 1/16   | Simp Sd. 4529                    |
|        | 5" @ 4529                        |
|        | TD 4539'                         |
|        | Bomb Pot. 1289                   |
|        | Grav. 40.0                       |

COMPLETED

KANSAS

Pool Name ShriverMap No. K-92 Sec. 27 Twp. 29 R. 14WWell No. 3 KerrSkelly

Company

## FIRST REPORT

Contractor

NE SW SW

## SECTION PLAT

|   |  |  |  |
|---|--|--|--|
|   |  |  |  |
|   |  |  |  |
|   |  |  |  |
| 0 |  |  |  |

       Ft. from N. Line990 Ft. from S. Line       Ft. from E. Line1000 Ft. from W. LinePratt CountyLocation       Rig up       Drilling and Remarks:  
derrick

## RECORD

Cased        in.,        ft.Sand       Gas       Oil       Total Depth       

## PRODUCTION

1st 24 hrs. Nat.       1st 24 hrs. after shot       Gas        Cu. Ft.Dry Hole       Abandoned       

Date

DEC 5 1945 19S. J. LEWIS

Scout

KANSAS

Kansas

Pool Name ShriverMap No. 92 Sec. 27 Twp. 29 R. 14WWell No. 3 KerrSkelly

Company

**COMPLETED**

Contractor


NE SW SW

E1/125  
SECTION PLAT

Ft. from N. Line

990 Ft. from S. Line

Ft. from E. Line

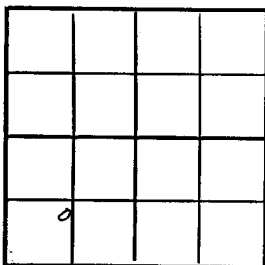1000 Ft. from W. Line

Pratt County

Location

Rig up

Drilling and Remarks:

Drilled 45295' 10" 4529Bore 128940" 1/4**RECORD**

Cased \_\_\_\_\_ in., \_\_\_\_\_ ft.

Sand \_\_\_\_\_

Gas \_\_\_\_\_

Oil \_\_\_\_\_

Total Depth 4529**PRODUCTION**

1st 24 hrs. Nat. \_\_\_\_\_

1st 24 hrs. after shot \_\_\_\_\_

Gas \_\_\_\_\_ Cu. Ft.

Dry Hole \_\_\_\_\_

Abandoned \_\_\_\_\_

Date

JAN 16 1946

19

S. J. LEWIS

Scout