


KANSAS Pratt

FORM 51 5M 6-46 PETROL

Section 27 Township 29 Range 14-W

Well No. #4 Kerr

Company Skelly

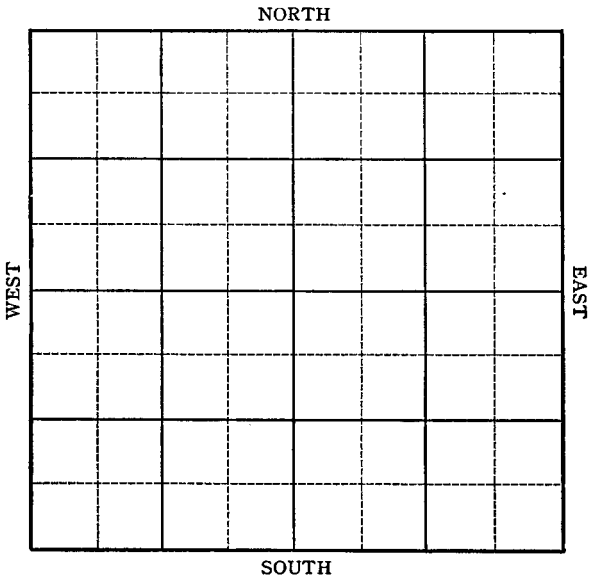

KANSAS

Pratt County



Sec. 27 Twp. 29 R. 14W

Well No. #4 Kerr Farm

Skelly Company

Shriver


990 Ft. from N. Line

 Ft. from S. Line

990 Ft. from E. Line

 Ft. from W. Line

SW NE SW

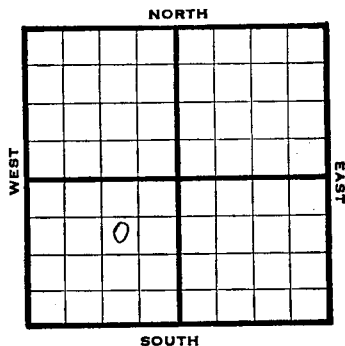

1946

REPORT

Elev. 1963'

8/14

Derrick

8/20

8" @ 777 WOC

8/27

Drlg 3220'

9/5

Drlg 4295'

9/10

Lans 4001'

Viola 4491'

Simp sd 4542'

TD 4545'

5" @ 4542 RUST

9/18

Simp sand 4542'

5" @ 4542'

Pump 344 oil plus 10% W Pot

TD 4548'

Grav. 40.

COMPLETED

Kansas Pool Name Shriver

KANSAS


Map No. 92 Sec. 27 Twp. 29 R. 14WWell No. 4 KerrSkelly

Company

FIRST REPORT

SW NE SW

Contractor

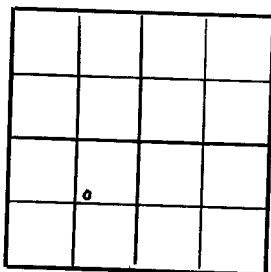SECTION PLAT990 Ft. from N. Line Ft. from S. Line990 Ft. from E. Line Ft. from W. LinePratt CountyLocation Rig up

Drilling and Remarks:

Derrick**RECORD**Cased in., ft.Sand Gas Oil Total Depth **PRODUCTION**1st 24 hrs. Nat. 1st 24 hrs. after shot Gas Cu. Ft.Dry Hole Abandoned

Date

AUG 14 194619S. J. LEWISScout

KANSAS

Kansas


Pool Name Shriver PoolMap No. 92 Sec. 27 Twp. 29 R. 14WWell No. 4 KerrSkelly

Company

COMPLETED

Contractor

SW NE SW

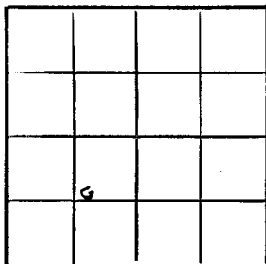E 11/963
SECTION PLAT990 Ft. from N. Line Ft. from S. Line990 Ft. from E. Line Ft. from W. LinePratt CountyLocation Rig up

Drilling and Remarks:

Simple Oct 4542
5' to 4542Prod 344 oil
+ 10% N.P.R.40° S.E.**RECORD**Cased in., ft.Sand Gas Oil Total Depth 4542**PRODUCTION**1st 24 hrs. Nat. 1st 24 hrs. after shot Gas Cu. Ft.Dry Hole Abandoned

Date

SEP 1 8 1946 19S. J. LEWIS Scout