


Kingman KANSAS

SECTION 27 TOWNSHIP 29 RANGE 10W

WELL NO. #1 Spade

COMPANY Aylward Drlg.

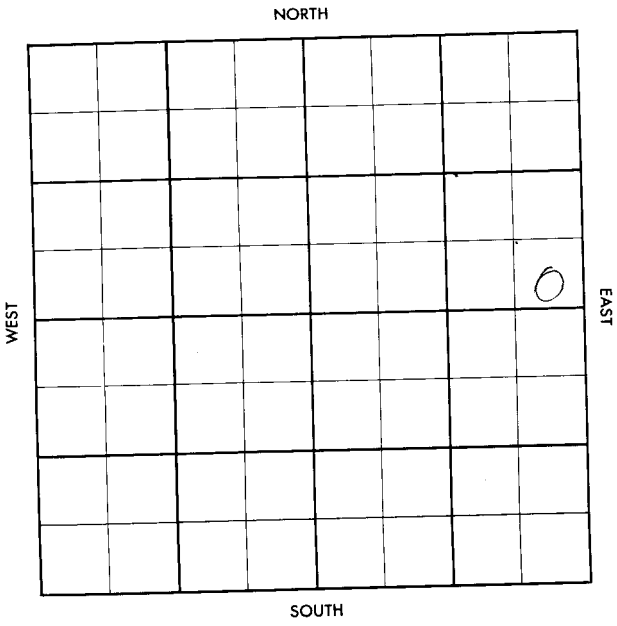


County Kingman Elev. _____
 Sec. 27 Twp. 29 Rge. 10W
 Company Arnward Drilg.
 Farm Name Sodde No. 1

	TOPS	DEPTH	LOG	DATUM
Anh.				
Tr.				
H.				
Tr.				
Dg.				
Bl.				
L.				
K.C.				
B.K.C.				
Ce.				
C.				
M.				
M.				
K.				
Mz.				
Ma.				
V.				
S.				
S.				
A.				
R.				
PE.				
G.				
TD.				

Loc. in Sec. SE SE NE

Geol. _____
 Contr. _____

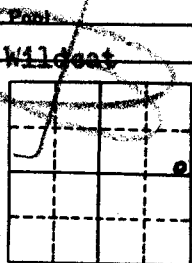

Date Comm. _____
 Location OCT 10 '56

FIRST REPORT

FORM 4 5 100

[Large handwritten signature or initials]

10 76

Loc. No. Sec. T. R.

County Kingman Elev. 1735
 Sec. 27 Twp. 29 Rge. 10W
 Company Aylward Dr. Co.
 Farm Name Slide No. 1

TOPS	DEPTH	LOG	DATUM	Loc. in Sec.
Ank				SE SE NE
Tr.				
H.	3536	3538		
Tr.				
Dg.	3607			
Bl.				
L.	3707	3724		
N.C. <u>Marion</u>	4170			Geol.
B.K.C.				Contr.
Ce.				
C.				
M.	4307	4307		
M.				
K.		4370		Pool
Mr.				Wildcat
Mo.				
V.	4583	4580		
S. <u>55</u>	4649	4648		
S.				
A.	4754	4754		ABANDONED
R.				
PE				
G.				
TD	4774			OCT 31 '56

Date Comm.

Location OCT 17 '56 10-12-56 8 5/8
260/85 ID 2685 OCT 24 '56 ID 4153
 OCT 31 '56 DIST 4309-27 2 hrs
rec 60' MW (550) BHP 1615/30
FBHP 1020/30. DST 4584-96 hrs
rec 14' Md All press 0

D & A