


Section 27 Township 29 Range 10W

Well No. 1 L. Spade Unit

Company Carter Oil & Cities Service

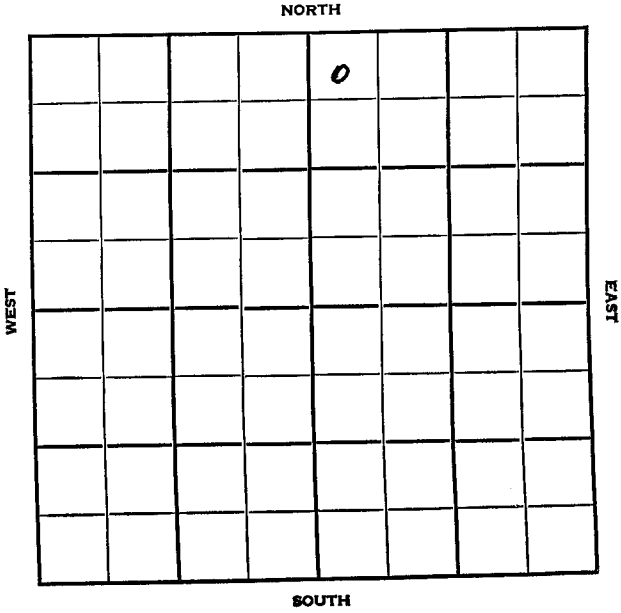

Kingman KANSAS

SEC.	TWP.	R.
27	29	10W


WELL NO. 1 L. Spade Unit FARM

COMPANY Carter Oil & Cities Service

CONTRACTOR

Wildcat

330 Ft. from N. Line
 _____ Ft. from S. Line
 _____ Ft. from E. Line
 330 Ft. from W. Line

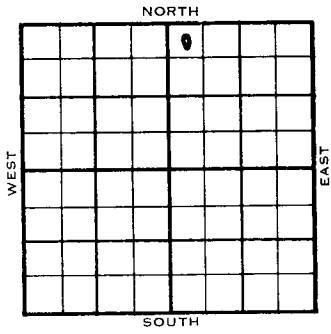

NW NW NE

	ELEVATION	REPORT
1954	1763'	

11/10
 1955
 3/2

Location

Spud 11-9-54 Oil well TD 4800
 8" @ 399 Heeb 3548 Dr lime 3740
 Lans 3766'
 DST 4121-39 open 1 hr rec 100' muddy
 SW. 1595# Dodge 3561' Doug 3576
 Miss. 4306'
 DST ~~4298-4320~~ 4298-4320 open 1 hr rec
 90' GCM. DST 4312-30 open 2 hr,
~~rec 510' gas, 190' SO &~~
~~DST 4312-30~~ GCM, 250#
 DST 4344-50 open 1 hr rec 30' SOCM
 328# Kh. 4380', Viola 4596'
 DST 4598-4606 open 1 hr rec 15' VSO
 & GCM 69# imp. 4651' Arb. 4766
 DST 4762-70 open 1 1/2 hr rec 420' SW
 1645#. TD 4800 5" @ 4694 70/4598-
 4610' S/8 GW 1 hr. 500 A B/10 BO
 5 BW 24 hrs. Sd-frac. PB 4340
 56/4312-21 dry. 200 M-A 500 A
 frac. S/20 BO 27 BW 8 hr. PB 4331
 P/14 BO 20 BW 8 hr. Comp. 6 BOPD
 21 BW.

COMPLETED

Drlg. Data

dry 200 M-A 500 A frac S/ 20 bo

27 bw 8 hr. PB 4331 P/ 14 bo 20 bw

8 hr. Comp. 6 bopd 21 bw

②

llll