
FORM 51 10M 2-49 PETROL KANSAS Grant

Section 27 Township 29 Range 36W

Well No. 1 Sullivan

Company Magnolia
~~Hugoton~~

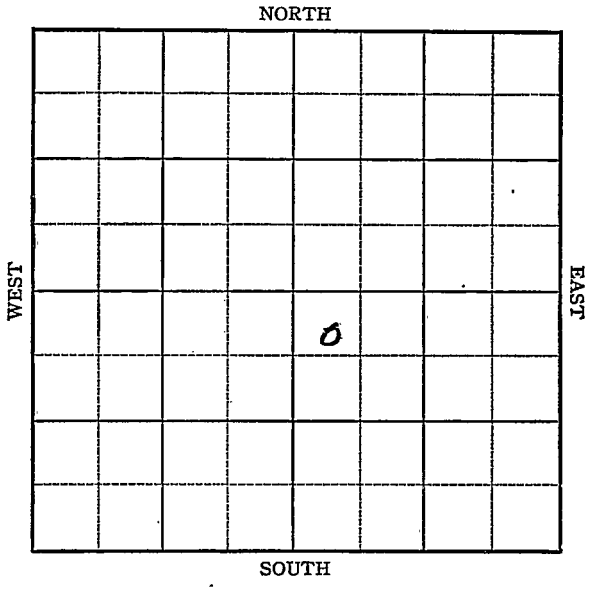

FORM 252-A
5M 10-48 PETROL

Grant KANSAS

Sec. 27 Twp. 29 R. 36W

Well No. #1 Sullivan Farm

Magnolia Company

Hugoton Pool (Keen Drlg., Cont.)


330' Ft. from N. Line

Ft. from S. Line

Ft. from E. Line

330' Ft. from W. Line

NW SE

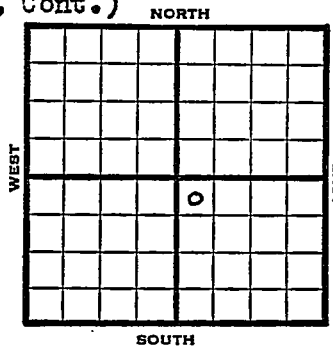

1949	Elev 2926' REPORT
7/20	10" @ 670'
7/27	TD 2800'
	7"@ 2789'
8/3	168 shots 2583-2616 - 7000 acid
8/10	552 shots 2399-2574
	28000 acid
8/17	"
8/24	TD 2665'
	7"@ 2664'
	Perf 35000 acid
	34,200,000 Gas
	384# R Pr.
	Comp
	COMPLETED

Form 26 200 Bks. 6-49 Petrol

Hugoton Pool

Kansas

Map No. ____ Sec. 27 Twp. 29 R. 36W

Well No. 1 Sullivan


Magnolia Company

Keen Drlg. Contractor

NW SE

FIRST REPORT

SECTION PLAT

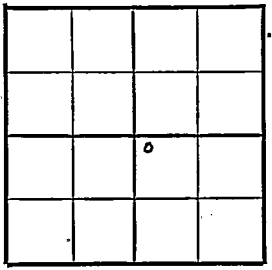

330 Ft. from N. Line

____ Ft. from S. Line

____ Ft. from E. Line

330 Ft. from W. Line

Grant County

Location

Rig up

Drilling and Remarks:

10" @ 670

RECORD

Cased ____ in., ____ ft.

Sand

Gas

Oil

Total Depth

PRODUCTION

1st 24 hrs. Nat.

1st 24 hrs. after shot

Gas ____ Cu. Ft.

Dry Hole

Abandoned

Date

JUL 20 1949 19

S. J. LEWIS Scout

Form 26 200 Bks. 6-49 Petrol

Kansas

Hugoton Pool

Map No. 2 Sec. 27 Twp. 29 R. 36W

Well No. 1 Sullivan

Magnolia Company


COMPLETE

Contractor

NW SE

E 1.2926

SECTION PLAT

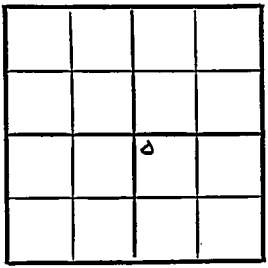

330 Ft. from N. Line

Ft. from S. Line

Ft. from E. Line

330 Ft. from W. Line

Grant County

Location

Rig up

Drilling and Remarks:

7" @ 2664

Perf

2800 acid

84,200,000 Gas

384# RP

RECORD

Cased in., ft.

Sand

Gas

Oil

Total Depth 2665'.

PRODUCTION

1st 24 hrs. Nat.

1st 24 hrs. after shot

Gas Cu. Ft.

Dry Hole

Abandoned

Date

AUG 24 1949 19

S. J. LEWIS Scout