


Section 27 Township 29 Range 32W

Well No. 1 Proksch

Company Kansas Natural Gas

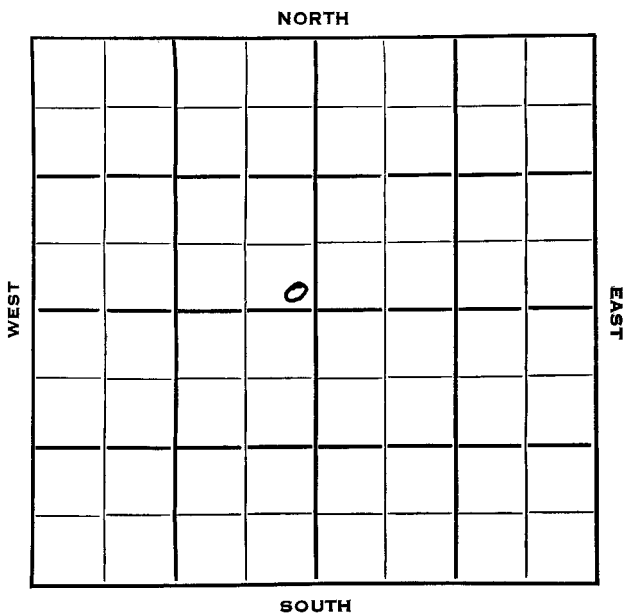


SEC.	TWP.	R.
27	29	32W

WELL NO. #1 Proksch FARM

COMPANY Kansas Natural Gas

CONTRACTOR B & R Drlg.

_____ Ft. from N. Line
 150 _____ Ft. from S. Line
 150 _____ Ft. from E. Line
 _____ Ft. from W. Line

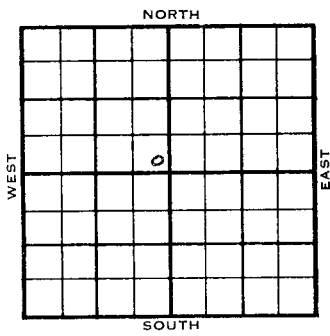

SE SE NW

1954	ELEVATION	REPORT
	2903'	
3/17		Location
3/24		10" @ 559' w/400 sks Drlg 2595'
3/31		RTD 2758' Her. 2664', Kr. 2684', Win 2740' 7" @ 2757'
4/7		WOCT.
5/5		Spud 3-17-54 Gas well TD 2758 10" @ 559 Her. 2664 Kri. 2684 Win. 2740 TD 2758 7" @ 2757 CO to 2741 CO to 2756 60/2744-54 1000 A PB 2726 84/2666-80 144/2694-2718 2000 A 876,000 gas. Frac. CO to 2758 2,450,000 gas. 18 hr. Comp. 9,085,000 gas.
		COMPLETED

