Kingman


DX 78-1

KANSAS

Section 27 Township 29 Range 7W

Well No. #2 Campbell

Company Drillers Prod. Co.

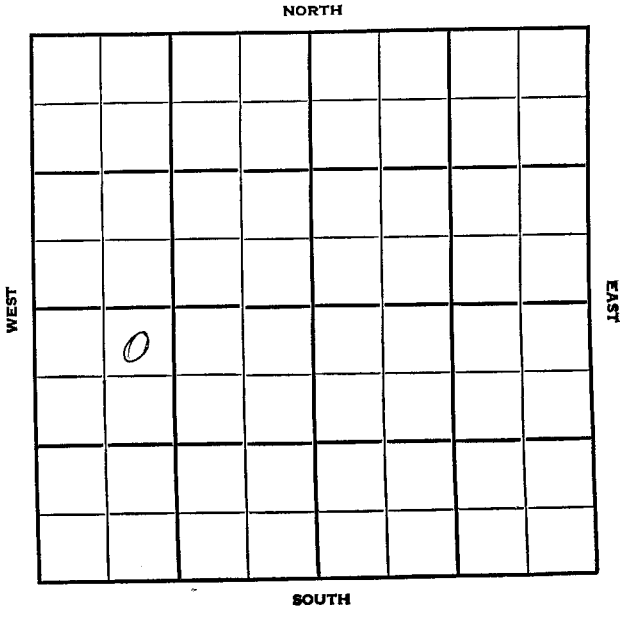

FORM 513 SUNRAY

County Kingman Elev.

Sec. 27 Twp. 29 Rge. 7W

Company Drillers Prod. Co.

Farm Name Campbell No. 2

TOPS	DEPTH	LOG	DATUM
Anh.			
Tp.			
H.			
Tr.			
Dg.			
Bl.			
L.			
K.C.			
B.K.C.			
Ce.			
C.			
M.			
M.			
K.			
Mz.			
Me.			
V.			
S.			
S.			
A			
R.			
P€.			
G.			
TD			

Loc. in Sec. NE NW SW

Geol.

Contr. Springer & Hawk per Tools

Pool Trenton

FIRST REPOR
D
NOV 21 56

Date Comm. spd. 11-16-56

8" @ 203 w/200, Drlg. 1025

Co.

No.

Sec.

T.

R.

FORM 513 SUNRAY

County Kingman Elev. ~~1521~~ 1516

Sec. 27 Twp. 29 Rge. 7W

Company Drillers Prod. Co.

Farm Name Campbell No. 2

TOPS	DEPTH	LOG	DATUM
Anh.			
Tp.			
H.	3090		
Tr.			
Dg. sd	3231		
Bl.			
L.	3323		
K.C.	3729		
B.K.C.	3825		
Ce.			
C.			
M. chert	4126		
M. LI	4142		
K.			
Mz.			
Mo.			
V.			
S.			
S.			
A			
R.			
P€.			
G.			
TD	4189		

Loc. in Sec. NE NW SW

Geol.

Contr. Springer & Ha~~per Tools~~

Pool Trenton

COMPLETE

JAN 16 '57

Date Comm. spd. 11-16-56

8" @ 203 w/200, Drlg. 1025 NOV 28 '56

TD 3565' DEC 5 '56 DST 4166-70

1hr 30' GCESOCM DHP 55/30"

5½ 4169/100 DEC 12 '56 CO 4189 PB

13½ Gaph + Tr. wtr & hrs S.I.

& hrs & 7 Gaph + 2 Gwph &

hrs to Acid DEC 19 '56 Frac

Flwd 380 BF 24 hrs 2/3 oil

DEC 26 '56 JAN 2 '57 JAN 9 '57 JAN 16 '57 Ph Flw

2 ST Build + 250' WTR & hrs 220