DX 78-1

Kingman KANSAS

Section 27 Township 29 Range 7W

Well No. 1 Voran

Company Cities Service

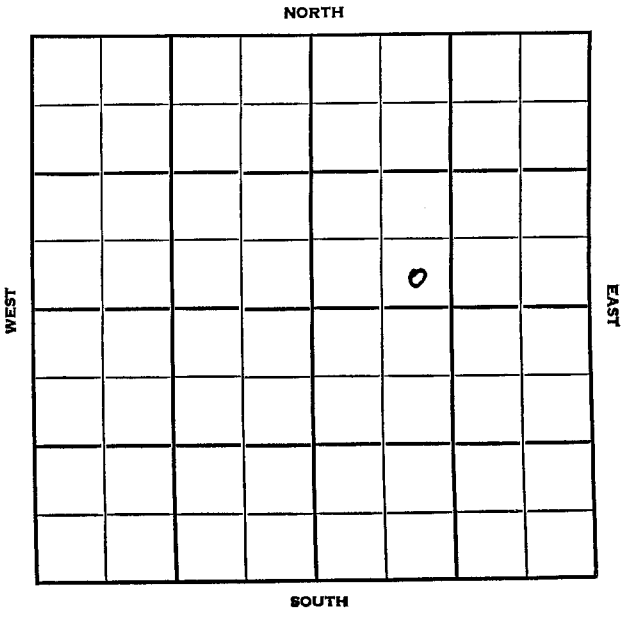

Kingman KANSAS

SEC.	TWP.	R.
27	29	7W

WELL NO.

1 Voran FARM

COMPANY

Cities Service

CONTRACTOR

_____ Ft. from N. Line

330 Ft. from S. Line

_____ Ft. from E. Line

990 Ft. from W. Line

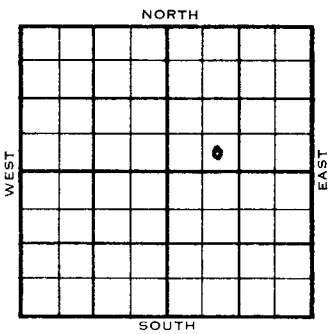

SE SW NE
Magnolia Ac

	ELEVATION	REPORT
1954	1531'	

11/10 Location

1955
1/26 Spud 11-12-54
Gas well TD 4665' 8" @ 402
Top. 2703 Heeb 3087 Dodge 3107
Doug. 3126 Lans 3324 B KC 3835
Miss. 4122
DST 4120-33, open 1 hr , gas in 2 min
588,000 CFG, rec 80' mud & wtr. 1800#
DST 4135-55, open ½ hr, gas in 20 min
rec 45' GCM, 175' GCM, 10' mud & SW
270#.
DST 4188-4224, open 1 hr rec 150' mud
Kh. 4394' Viola 4509' Simp sd 4511'
Arb. 4629' TD 4665' 5" @ 4300
GO to 4277 51/4181-94 1000 A 3 BO
113 BW 24 hrs. SP 4174 48/4129-38
3 GO. 18 GWPH sd-frac. F/1½ BW 2
3,180,000 CFG. Dec. to 2,000,000 CFG
GO to 4127 35/4111-23 sd-frac.
SI 3 hr. 1,047,000 CFG 1220#
Comp. 1,030,000 CFG 1395#

COMPLETED

DX-78

FORM 275 FOR SALE BY KANSAS BLUE PRINT CO

County Kingman State Kansas

Sec. 27 (Blk. Twp.) 29 (Sur. Rge.) 7W Map No.

Operator Cities Service

Well No. 1 Farm Voran

Elev. Location SE SW NE

					0		
FIRST REPORT							

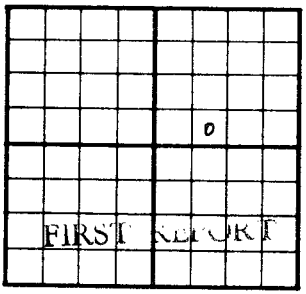

330 Ft. From S Line NE

990 Ft. From W Line Quarter

1st. Report NOV 1

Completion

Remarks Magnolia - AC

Spudding Date

Drlg. Data

Location

FABEN GILSTRAP

FORM 275 FOR SALE BY KANSAS BLUE PRINT CO

County Kingman State Kansas

Sec. 27 (Blk. Twp.) 29 (Sur. Rge.) 7W Map No.

Operator Cities Service

Well No. 1 Farm Voran

Elev. 1531 Location SE SW NE

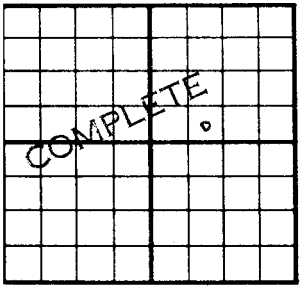

330 Ft. From S Line NE

990 Ft. From W Line Quarter

1st. Report

Completion JAN 26 1955

Remarks

Spudding Date 11-12-54

Drlg. Data Gas well TD 4665

8" @ 402 Top. 2703 Heeb. 3087

Dodge 3107 Doug. 3126 Lans. 3324

B KC 3835 Miss. 4122 DST 4120-33

open 1 hr. gas in 2 min. 588,000 cfg

Rec. 80' mud & wtr. 1800# DST 4135-55

open ½ hr. gas in 20 min. Rec. 45' gcm

175' gcm 10' mud & sw 270#

DST 4188-4224 open 1 hr. Rec. 150' mud

Kh. 4394 Viola 4509 Simp. sd. 4511

Arb. 4629 TD 4665 5" @ 4300

CO to 4277 51/ 4181-94 1000 A

3 bo 113 bw 24 hr. SP 4174 48/ 4129-3

3 go 18 gwph sd-frac F/ 1½ bw 2 hr.

3,180,000 cfg dec. to 2,000,000 cfg

FARFN GILSTRAP