

Kingman

KANSAS

27

29

7W


SECTION _____ TOWNSHIP _____ RANGE _____

#1 Voran

WELL NO. _____

COMPANY Drillers Production

NORTH

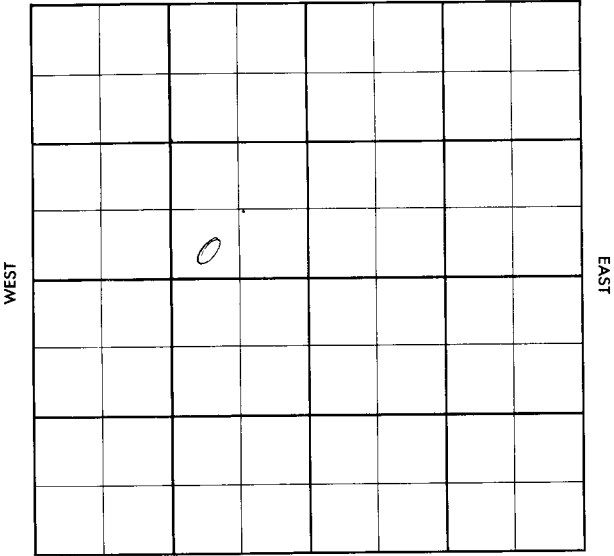

SOUTH

TOPS	DEPTH	LOG	DATUM	Loc. in Sec. _____
Anh.				SW SE NW
Tr.				
H.				
Tr.				
Dg.				
Bl.				
L.				Geol. _____
K.C.				
B.M.C.				Contr. Springer
Ce.				Harper
C.				
M.				Pool
M.				
K.				
Mz.				Trenton
Me.				
V.				
S.				
S.				
A.				
R.				
PE.				
G.				
EP.				

FIRST REPORT

OCT 3 '56

No. _____

Date Comm.

1990

100

County Kinross Sec. 27 Twp. 29S Rge. 7W
 Company Drillers Production
 Farm Name Voran No. 1

TOPS	DEPTH	LOG	DATUM	Lot in Sec.
Ant.				8W 8E NW
TP				
H.	3089			
TR				
D ₁ <u>54</u>	3123			
D ₂ <u>115 3d</u>	3230			
L.	3322			
R.C.				Geol.
R.K.	3820			Conts. Springer
Co.				Harper
C.				Pool
M. <u>chert</u>	4114			Trenton
M. <u>LI</u>	4147			
K.				
Ma.				
Me.				
V.				
S.				
S.				
A.				
R.				
PC.				
G.				
TD	4149			COMPLETE

Date Comm. LOO OCT 10 56 10-8-56 8578 209
1200 WCC OCT 17 56 P. 3020
OCT 24 56 DET 4116-30 1hr 6/6"
90 120 MCF acc 85' GCM
FP 54-54 BHP 1436/20"
5 1/2 4149 / WOOT OCT 31 56 COM 7
DD 4149 4184 1/2 FU 39 60 +
35 GW in 67 hrs DD 4203 TP
P 320 60 + 16 GW in 18 hrs

Frac Flw 10 Boph & 2 hrs

+ 1,600 MCFG NOV 21 '36 NOV 28 '36 DEC 5 '36

DEC 12 '36

DEC 19 '36

Ph Flw 425

Bopd + 4% WT + 1,464 MCFG

gran 32°