KANSAS

Kingman

SECTION 27 TOWNSHIP 29 RANGE 7W

WELL NO. #1 Voran "B"

COMPANY Drillers Prod.

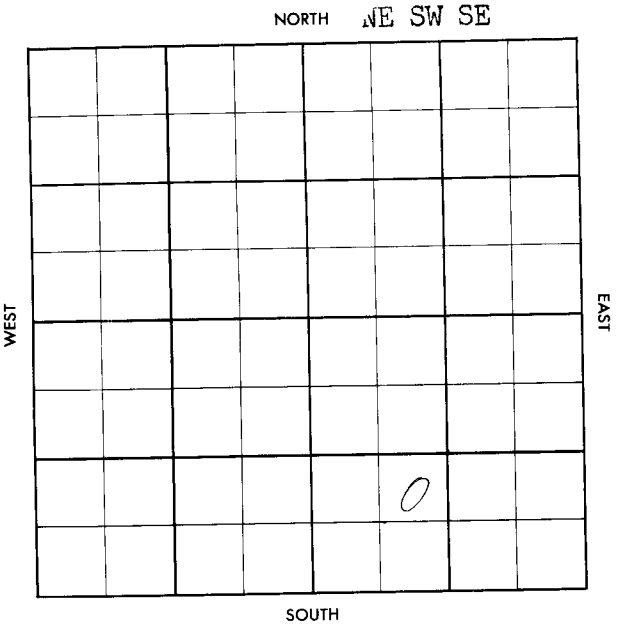

FORM 504-3 SUNRAY

FORM 513 SUNRAY

County Kingman Elev.

Sec. 27 Twp. 29 Rge. 7W

Company Drillers Prod.

Farm Name Voran "B" No. 1

TOPS	DEPTH	LOG	DATUM
Anh.			
Tp.			
H.			
Tr.			
Dg.			
Bl.			
L.			
K.C.			
B.K.C.			
Ce.			
C.			
M.			
M.			
K.			
Mz.			
Me.			
V.			
S.			
S.			
A			
R.			
Pe.			
G.			
TD			

Loc. in Sec. NE SW SE

Geol.

Contr. Springer & Harper

Pool Voran

FIRST REPORT

MAR 13 57

Date Comm. 3-8-57

8" @ 220/200, Drlg. 914

27

Co. Lse. No. Sec. T. R.

FORM 513 SUNRAY

County Kingman Elev. 1517

Sec. 27 Twp. 29 Rge. 7W

Company Drillers Prod.

Farm Name Voran "B" No. 1

TOPS	DEPTH	LOG	DATUM
Anh.			
Tp.			
H.			
Tr.			
Dg.			
Bl.			
L.			
K.C.			
B.K.C.			
Ce.			
C.			
M.	4114		
M. 61	4141		
K.			
Mz.			
Mo.			
V.			
S.			
S.			
A			
R.			
P€.			
G.			
TD	4173		

Loc. in Sec. NE SW SE

Geol.

Contr. Springer & Harper

Pool Voran

COMPLETE

APR 24 '57

Date Comm. 3-8-57

8" @ 220/200, Drlg. 914 MAR 20 '57 ⌀ 3527

MAR 27 '57 5½ 4164 APR 3 '57 CO DD

4188 B 6 GO + 1 GWph

8 hrs DD 4189½ TD APR 10 '57 X

Frac Flwd Load + 100 B new

oil in 12 hrs Thrs 2" Tbg + stg.

APR 17 '57 Flwd 18.56 Boph 2 hrs

25/64" ch cp 890 TP 900#

APR 24 '57 BH Bomb Flw 2866 Bopd

+ 3% wtr grav. ?

Co. Lse. No. Sec. T. R.