

Kingman

KANSAS

27


29

7W

SECTION _____ TOWNSHIP _____ RANGE _____

WELL NO. #2 Voran "B"

COMPANY Drillers Prod.

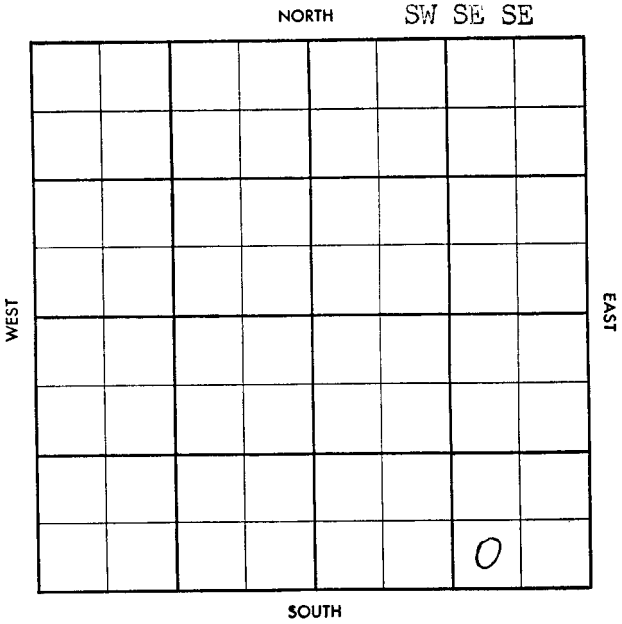

27

~~Trenton~~

CO. Kingman ELEV 15050

DEC 11 57

SEC. 27 TWP. 29 RGE. 7W

COMPLETE

COMPANY Drillers Prod. NO. 2

FARM Voran "B"

LOC. SW SE SE

L 3301	
Mk: 4105	
Mdel 4115	
TD 4173	

GEOL. _____

CONTR. Gabbert & Jones

POOL Trenton

SPUD 10-12-57

8" @ 252 w/225, Dflg.

1485. ~~1485~~ ϕ 3650

no + tests

54 4151

NOV 5 57 CO 4173 $\frac{1}{2}$

ϕ $\frac{1}{2}$ 90 + $2\frac{1}{2}$ gw ph 9 hrs

DD 4177 ϕ $2\frac{1}{2}$ 90 + 1 gw ph

3 hrs frac flo ~~191~~ 191

BO 4090 W NT

Flo 15130 ph + 4090 W

gw 644 mcf NOV 13 57 NOV 20 57

state test

50 BO + 159 cupd

in 31° flowing

CO. LSE. SEC. TWP. RGE.