Kingman KANSAS

SECTION 27 TOWNSHIP 29 RANGE 7W

WELL NO. #1 Voran "C"

COMPANY Cities Service

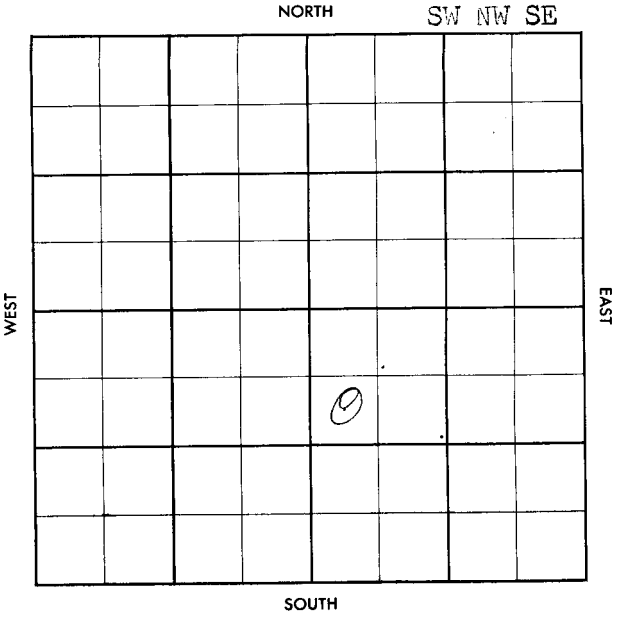

FORM 504-3 SUNRAY

FORM 513 SUNRAY

County Kingman Elev. Co.

Sec. 27 Twp. 29 Rge. 7W

Company Cities Service

Farm Name Voran "C" No. 1

TOPS	DEPTH	LOG	DATUM
Anh.			
Tp.			
H.			
Tr.			
Dg.			
Bl.			
L.			
K.C.			
B.K.C.			
Ce.			
C.			
M.			
M.			
K.			
Mz.			
Mc.			
V.			
S.			
S.			
A			
R.			
P€.			
G.			
TD			

Loc. in Sec. SW NW SE

Geol.

Contr. Barbour Tools

Pool Voran

FIRST REPORT

JUN 5 '57

Date Comm. MIRT

Sec. T. R.

FORM 513 SUNRAY

County Kinsman Elev. 1520

Sec. 27 Twp. 29 Rge. 7W

Company Cities Service

Farm Name Voran "C" No. 1

TOPS	DEPTH	LOG	DATUM
Anh.			
Tp.			
H.	3086		
Tr. Dodge	3098		
Dg.	3117		
Bl.			
L.	3319		
K.C.			
B.K.C.	3824		
Ce.			
C.			
M.	4116		
M. 41	4131		
K.			
Mz.			
Mo.			
V.			
S.			
S.			
A			
R.			
P€.			
Q.			
TD	4155		

Loc. in Sec. SW NW SE

Geol.

Contr. Barbour Tool

Pool Voran

COMPLETE

Q

AUG 14 '57

Date Comm.

MIRT JUN 12 '57 6-4-57 PS/F

410/275 ND 2945 JUN 19 '57 ØD 4061

JUN 26 '57 DST 4118-30 1hr G/4"

ga 175 MCFG no 50! Md BHP

1385 DST 4129-40 1hr 45"

Md 1243/30" DST 4139-55

1hr 60 VHO & GCM + 45' OIL

BHP 1130/30" 5¼ 4142 JUL 3 '57

DD 4173 tst & Laph Frac

FORM 513-1 SUNRAY

Flwd 23 BO + 2% wtr
1 hr 20/64" ch TP 600 #
JUL 10 57 JUL 17 57 Flwd 388 BO + 62
BW 19 hrs 22/64" ch GOR
550:1 JUL 24 57 S.I. JUL 31 57 Flow
141 BO + 12 BW 24 hrs 22/64" ch
AUG 6 57 Flowed 342 BO + 35
BW in 15 hrs 22/64" ch 15 hrs
AUG 14 57 Pk Flow 507 Bopd
+ 8% wtr GOR 796:1