


Kingman

KANSAS

SECTION 27 TOWNSHIP 29 RANGE 7W

WELL NO. #2 Voran "A"

COMPANY Drillers Prod.

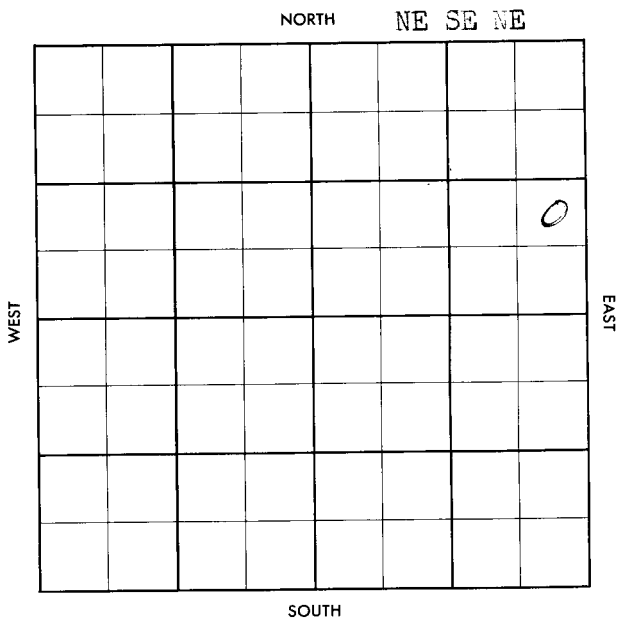

County Kingman

Elev. _____

Sec. 27

Twp. 29

Rge. 7W

Company Drillers Prod.

Farm Name Voran "A"

No. 2

TOPS	DEPTH	LOG	DATUM
Ans.			
Tr.			
H.			
Tr.			
Dg.			
Bl.			
L.			
K.C.			
B.K.C.			
Ce.			
C.			
M.			
M.			
K.			
Mz.			
Ma.			
V.			
S.			
A.			
R.			
Pe.			
G.			
TD			

Loc. in Sec. _____

NE SE NE

Geol. _____

Contr. _____

Gabbert-Jones

Pool _____

Voran

APR 17 57

FIRST REPORT

Date Comm. 4-15-57 Magnolia (FO)

8" @ 216, WOC

27

Co.

W

Sec.

T.

R.

County Kiowa Elev. 1539
 Sec. 27 Twp. 29 Rge. TW
 Company Drillers Prod.
 Farm Name Voran "A" No. 2

	TOPS	DEPTH	LOG	DATUM
Anh.				
Tp.				
H.		3090		
Tr.				
Dg.				
Bl.				
L.		3322		
K.C.				
B.K.C.				
Ce.				
C.				
M.		4128		
M.				
K.				
Mz.				
Me.				
V.				
S.				
S.				
A.				
R.				
PE.				
G.				
TD		4198		

Loc. in Sec. NE SE NE
 Geol. _____
 Contr. Gabbert-Jones
 Pool Voran

	JUN 2 57	
COMPLETE		

Date Comm. 4-15-57 Magnolia (FO)
 8" @ 216, WOC 4424 57 ϕ 3565 MAY 1 57
 5 1/2" 4198/125 DD 4214
 TD β 12 G0 + 10 Gwph 5 hrs
 To FRAC MAY 15 57 FRAC Flwd
 6 B0 + 6 Bwph 18 hrs
 Flwd 9 B0ph + 40% wt 4
 hrs TP 300# CP 1280 MAY 22 57
 MAY 22 57 JUN 5 57 3565 BH Bomb
 2565 B0pd 10% wt.