Kingman

KANSAS

SECTION 27 TOWNSHIP 29S RANGE 7W

WELL NO. #2 Voran "A"

COMPANY C. S. O.

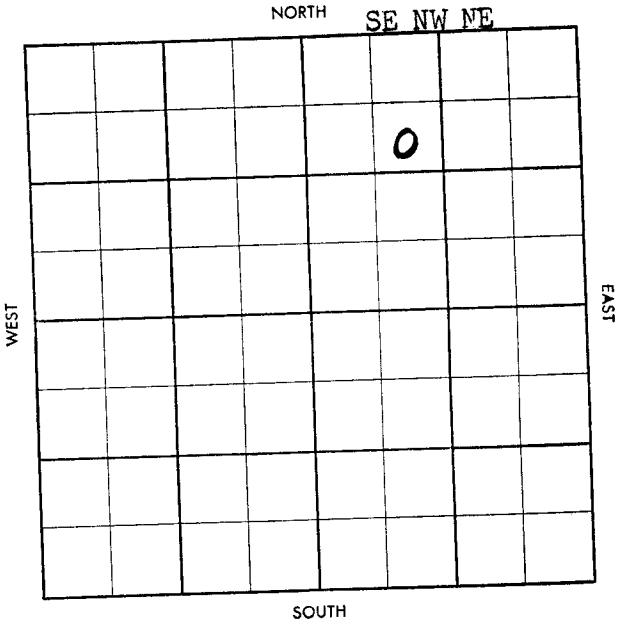

FORM 504-3 SUNRAY

Twp. Pool

Co. Farm

27

S-513-B

County Kingman Elev.

Sec. 27 Twp. 29 Rge. 7W

Company C. S. O.

Farm Name Voran "A" No. 2

TOPS	DEPTH	LOG	DATUM
Anh.			
Tp.			
H.			
Tr.			
Dg.			
B. L.			
L.			
K.C.			
B.K.C.			
Ce.			
C.			
M.			
M.			
K.			
Mz.			
Mq.			
V.			
S.			
S.			
A.			
R.			
Pf.			
G.			
T.D.			

Loc. in Sec. SE NW NE

Geol.

Contr. Barbour #17

Pool Trenton

APR 23 '58 FIRST REPORT



Date Comm. 4/20/58

8" @ 408 w/250, Drlg. 1660.

Co. Lse. No. Sec. T. R.

Twp. Pool

Qu. Facet

S-313-B

County Kingman Elev. 1539DF 1542RB

Sec. 27 Twp. 29 Rge. 7W

Company C. S. O.

Farm Name Voran "A" No. 2

TOPS	DEPTH	LOG	DATUM
Anh.			
Tp.			
H.	3882		
Tr. Dodge	3916		
Cg.	3975		
B.L.			
L.	4318		
K.C.			
B.K.C.	4330		
Ce.			
C.			
M.	4424		
M.			
K.			
Mz.			
Mq.			
V.			
S.			
S.			
A.			
R.			
Pf.			
G.			
T.D.	4709		

Loc. in Sec. SE NW NE

Geol.

Contr. Barbour #17

Lse.

Pool Trenton

COMPLETE

JUL 2 '58

No.

Date Comm. 6/20/58

Sec.

8" @ 408 w/250, Drlg. 1660. APR 30 '58

T.

#3902 MAY 7 '58 DST 4125 - 44 1 hr

R.

gas 572 mcf 100' M BHP 1400/30

DST 4144-54 1 hr 94' gcm spks oil

BHP 680/30 DST 4154-69 1 hr 130'

SOCM BHP 320/30 DST 4169-84 1 hr

110' SOCM BHP 310/30 DST 4185-91 1 hr

10' SOCM 30' M BHP 420/30 DST 4192-4209

1 hr 96' M BHP 210/30 DST 4195-4209

1 hr 120 SOCM BHP 790/30 MAY 14 '58

FORM 815-1 SUNRAY 5" 4199/150

eo 4209 13go 6½ gwph
14 hrs to DD MAY 21 '58 DD 4212
12go 9gwph vibro frac
1½ BFPh 20%w sd frac Flo
5 BFPh 45%w est 1.000 mcf
1" chk FCP 650 FTP 440 MAY 28 '58
JUN 11 '58 JUN 18 '68 Flo 75BO 75BW
JUN 3 '58
24 hrs 26/64" chk gr 990 mcf
JUN 25 '58 JUL 2 '58 Phy Flo 46BO
45BW 24 hrs 25/64" ck
gr 1.125 mcf
GOR 24,400 - 1
FTP 435 FCP 700
gr 32'
allow 31BO pd

27-29-7W SE NW NE