
Kingman KANSAS

SECTION 27 TOWNSHIP 29S RANGE 7W

WELL NO. #1-W-Voran "B"

COMPANY Drillers Prod.

C SW SE

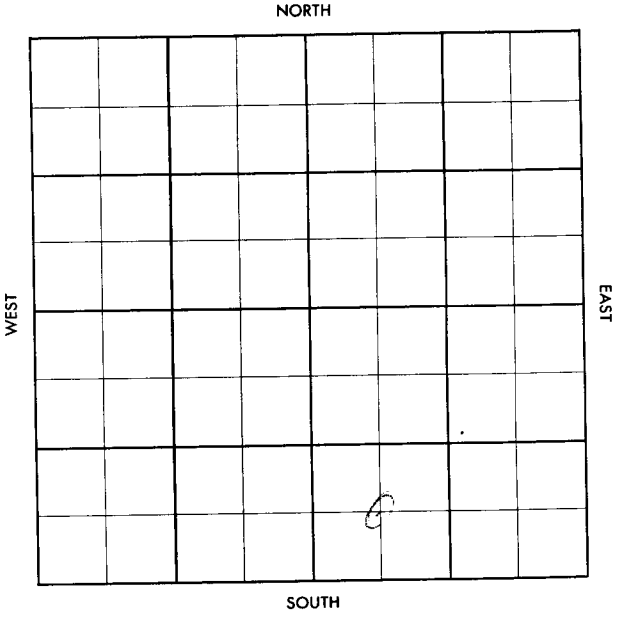

FORM 504-3 SUNRAY

FORM 513 SUNRAY

County Kingman Elev.

Sec. 27 Twp. 29 Rge. 7W

Company Drillers Prod.

Farm Name Voran "B" No. 1-W

TOPS	DEPTH	LOG	DATUM
Anh.			
T.P.			
H.			
Tr.			
Dg.			
B.L.			
L.			
K.C.			
B.K.C.			
Ce.			
C.			
M.			
M.			
K.			
Mz.			
Me.			
V.			
S.			
S.			
A			
R.			
Pc.			
G.			
TD			

Loc. in Sec. C SW SE S.W.D.W.

Geol.

Contr. Gabbert-Jones

Pool Voran

JUL 3 '57

FIRST REPORT

Date Comm. 6-27-57

8" @ 259/200, Drlg. 2714

Co.

Sec.

T.

R.

FORM 513 SUNRAY

County Kingman Elev. 1513 Co.

Sec. 27 Twp. 29 Rge. 7W

Company Drillers Prod.

Farm Name Voran "B" No. 1-W

TOPS	DEPTH	LOG	DATUM
Anh.			
Tp.	2696		
H.			
Tr.			
Dg. Sd	3197		
Bl.			
L.			
K.C.			
B.K.C.			
Ce.			
C.			
M.			
M.			
K.			
Mz.			
Mo.			
V.			
S.			
S.			
A			
R.			
P€.			
G.			
T.D.	3293		

Loc. in Sec. C SW SE

S.W.D.W.

Geol.

Contr. Gabbert-Jones

Pool Trenton

Voran

ABANDONED

JUL 17 57

Date Comm. 6-27-57

8" @ 259/200, Drlg. 2714 JUL 10 57 5½

3230 MICT CO CO 3293

Input 12 Bwph

Comp SWD well

Lse. No. Sec. T. R.