
Kingman KANSAS

SECTION 27 TOWNSHIP 29 RANGE 7W

WELL NO. #2 Voran "C"

COMPANY Cities Service

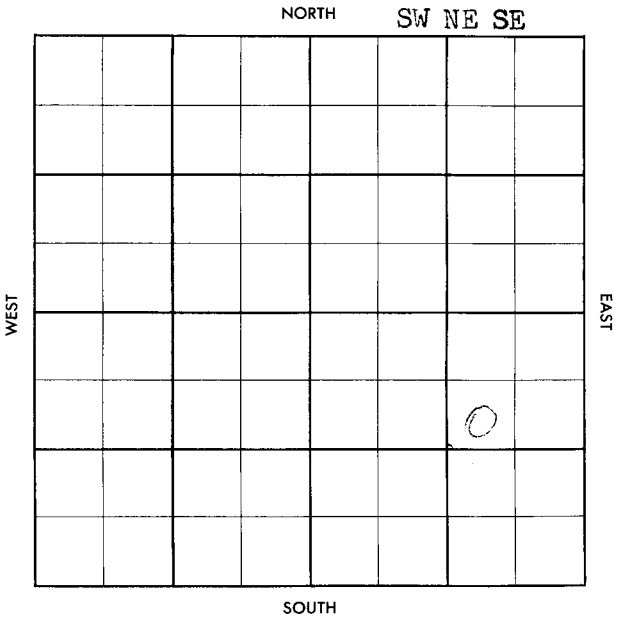

FORM 504-3 SUNRAY

FORM 513 SUNRAY

County Kingman Elev.

Sec. 27 Twp. 29 Rge. 7W

Company Cities Service

Farm Name Voran "C" No. 2

TOPS	DEPTH	LOG	DATUM
Anh.			
Tp.			
H.			
Tr.			
Dg.			
Bl.			
L.			
K.C.			
B.K.C.			
Ce.			
C.			
M.			
M.			
K.			
Mz.			
Me.			
V.			
S.			
S.			
A			
R.			
Pc.			
G.			
TD			

Loc. in Sec. SW NE SE

Geol.

Contr. Prime Drlg.

Pool Voran

FIRST REPORT

JN 31 57 O

Date Comm.

M I R T

27

Trenton

FORM 513 SUNRAY

County Kingman Elev. 1513

Sec. 27 Twp. 29 Rge. 7W

Company Cities Service

Farm Name Voran "C" No. 2

TOPS	DEPTH	LOG	DATUM
Anh.			
Tp.			
H.	3065		
Tr.			
Dg.			
Bl.			
L.	3303		
K.C.			
B.K.C.	3804		
Ce.			
C.			
M.	4101		
M.			
K.			
Mz.			
Me.			
V.			
S.			
S.			
A			
R.			
Pé.			
G.			
T.D.	4165		

Loc. in Sec. SW NE SE

Geol.

Contr. Prime Drlg.

Pool Voran

COMPLETE

OCT 30 '57

Co. Lse. No. Sec. T. R.

Date Comm.

MIRT 7-30-57 8 5/8

405/250 # 3300 DST

4103-16 1hr ga 1.400 MCFG

BHP 1405/30" 75' GCM

DST 4116-26 1hr 6/6" ga

110' GCM BHP 1480/30" DST

4143-54 # 4158 w150 DD 4180

S 5 Bo + 5 Bw lite hme Frac P. 18

Bo + 46 Bw 13 hme

27- 29 -7W

FORM 513-1 SUNRAY

SEP 4 '57 SEP 11 '57 SEP 18 '57

Flw 32BO 4YBW 24hrs

20/64" died pdy

SEP 25 '57 OCT 2 '57 OCT 9 '57

F-lo 72BO 20BW 24hrs

OCT 16 '57 OCT 23 '57 OCT 30 '57

PHY 54BO 102BW 24hrs

MISS 4/56-80