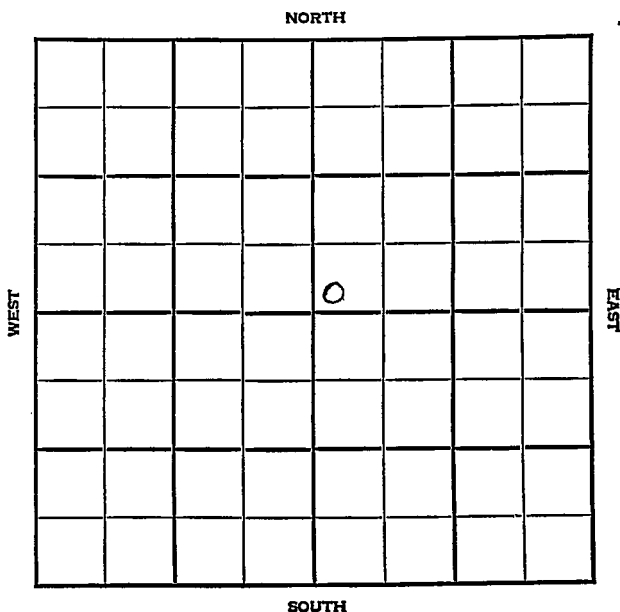


Section 27 Township 29 Range 39WWell No. 1 FellCompany Stanolind

KANSAS

Stanton County

Sec. 27 Twp. 29 R. 39W

Well No. #1 Fell Farm

Stanolind Oil Company

Houghton Pool


150 Ft. from N. Line

150 Ft. from S. Line

_____ Ft. from E. Line

150 Ft. from W. Line

SW NE

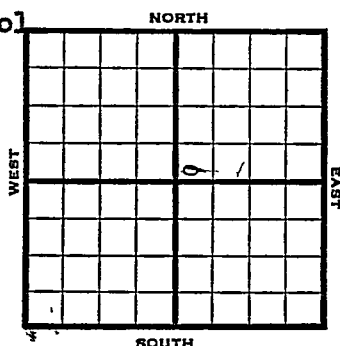

1948

E1 3200'

R E P O R T

4/21

Location

4/28

"

5/5

"

5/12

10" @ 590'
Drlg. 1228'

5/19

TD 2337'
7" @ 2314'

5/26

"

6/1

"

6/9

TD 2535'

6/16

248' of 5" Perf liner 2535'
16,000 acid

6/23

TD 2535'
7"@ 2314'
248' of 5" perf liner @ 2535'
16000 acid 6,115,000 Gas
Comp

COMPLETED

Map No. _____ Sec. 27 Twp. 29 R. 39WWell No. 1 Fell

_____ Stanclind _____ Company


_____ FIRST REPORT _____ Contractor

SW NE

SECTION PLAT

150 Ft. from N. Line150 Ft. from S. Line

_____ Ft. from E. Line

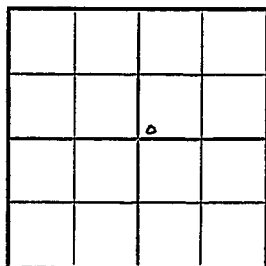150 Ft. from W. Line

Stanton County

Location X

Rig up _____

Drilling and Remarks:

RECORD

Cased _____ in., _____ ft.

Sand _____

Gas _____

Oil _____

Total Depth _____

PRODUCTION

1st 24 hrs. Nat. _____

1st 24 hrs. after shot _____

Gas _____ Cu. Ft.

Dry Hole _____

Abandoned _____

Date

APR 21 1948

19

S. J. LEWIS

Scout

Kansas

Map No. _____ Sec. 27 Twp. 29 R. 39WWell No. 1 Fell

Stanolind

Company

COMPLETE

Contractor

SW NE

E13200
SECTION PLAT

____ Ft. from N. Line

150 Ft. from S. Line

____ Ft. from E. Line

150 Ft. from W. Line

		0	
3			

Stanton County

Location _____

Rig up _____

Drilling and Remarks:

2" @ 2314248 1/2' 5" Prof line@ 253516000 Acid6, 115,000 Gas440 # RPH

RECORD

Cased _____ in., _____ ft.

Sand _____

Gas _____

Oil _____

Total Depth 2535

PRODUCTION

1st 24 hrs. Nat. _____

1st 24 hrs. after shot: _____

Gas _____ Cu. Ft.

Dry Hole _____

Abandoned _____

Date

JUN 23 194819S. J. LEWIS

Scout