

27

29


18W

SECTION _____ TOWNSHIP _____ RANGE _____

WELL NO. #4 Greenwood

COMPANY Ohio Oil

NORTH C SW SW

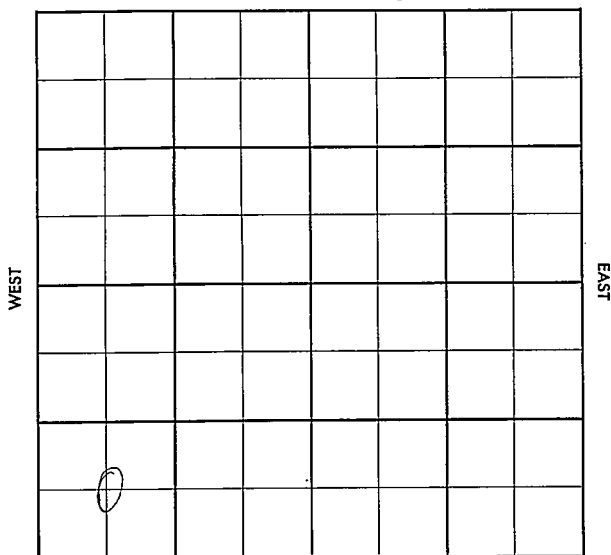

SOUTH

County Klowa Elev. _____
 Sec. 27 Twp. 29 Rge. 18W
 Company Ohio Oil
 Farm Name Greenwood No. 1

TOPS	DEPTH	LOG	DATUM
Anh.			
Tp.			
H.			
Tr.			
Dg.			
Bl.			
L.			
K.C.			
B.K.C.			
Ce.			
C.			
M.			
M.			
K.			
Mz.			
Ms.			
V.			
S.			
S.			
A.			
R.			
Pe.			
G.			
TD.			

Loc. in Sec. C SW SW
 Geol. _____
 Contr. _____
 Langford
 Pool _____
 Nichols
 FIRST REPORT
 JAN 23 '57
 0

Date Comm. RUB
 25

Co.
 Use.
 No.
 Sec.
 T.
 R.

County Iowa Elev. 2177
 Sec. 27 Twp. 29 Rge. 1st
 Company Ohio Oil
 Farm Name Greenwood No. 1

TOPS	DEPTH	LOG	DATUM	Loc. in Sec.
Anh.				C SW 1/4
Tp.				
H.	4009			
Tr.				
Dg.				
BL.	4277			
L.				
K.C.	4291		-710	Geol.
BKC.				Contr.
Ce.				Langford
C.				
M.	4901		2724	Pool
M.				Nichols
K.				
Mz.				
Mo.				
V.				
S.				
S.				
A.				
R.				
PE.				
G.				
T.D.	4934			

COMPLETE
 MAY 8 '57
 0

Date Comm.

RUP JAN 20 '57 X 1-24-57 10 3/4
 409/250 WOC : 3225
 FEB 13 '57 4716 FEB 20 '57
 DST 4922-32 1hr. G/5"
 9a 165 MCF/10" 90 MCF/25"
 net 3100' 9554 oil + 10' MW
 FP 260-680 1535/20" 5 1/2
 4930/225 FEB 27 '57 MILT CO. MAR 1 '57
 CO 4934, 1/2 Flowed 89 B0

notw 24 hrs 10/64" ch FTP 125

graw 35.6° N. 1 57 MAR. C 56 MAR 27 57

MAR 3 57 APR 10 57 APR 12 57 APR 24 57 MAY 1 57

MAR 5 57 Flwd 91 Bopd notw

14/64" ch GOR 276.1

FTP 125 #