


DX 78-1 Kiowa

KANSAS

Section 27 Township 29 Range 18W

Well No. #1 Mollie Greenwood

Company Ohio

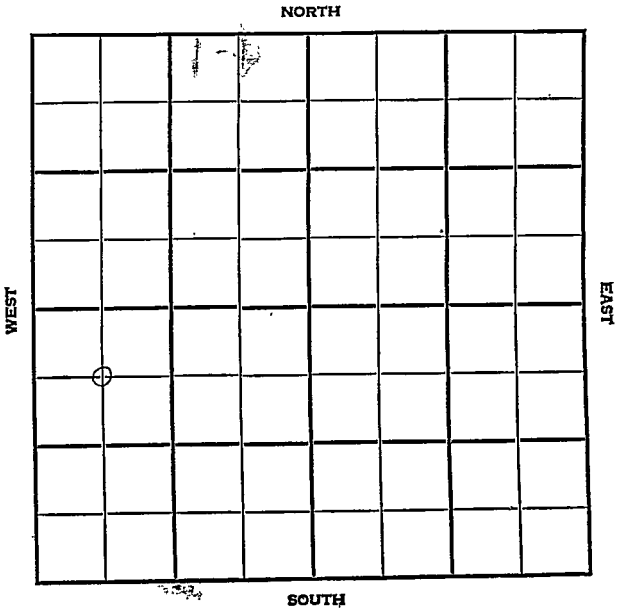

Kiowa

KANSAS

SEC.

TWP.

R.

27

29

18W

WELL NO.

#1 Mollie Greenwood

COMPANY

FARM


Ohio

CONTRACTOR

H & H

Nichols

NORTH

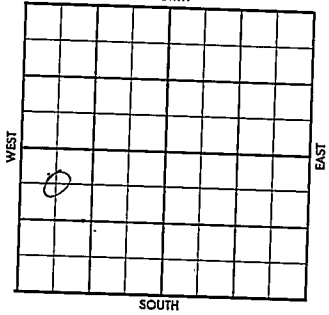

_____ FT. FROM N. LINE

_____ FT. FROM S. LINE

_____ FT. FROM E. LINE

_____ FT. FROM W. LINE

C NW SW

SDX - 3/8 mile

1956

ELEVATION

2196'

REPORT

8-1

MIR

8-9

Spud 8-1-56
8 5/8" @ 360 w/225
Drlg. 2604'

8-13

Drlg. 4055'

8-23

Lans. 4296'; Miss. 4902';
DST 4896-4941', op 1 hr, gas in 6 1/2 min
F/ oil in 30 min. rec. 1250' oil,
100' SW, 1650/20".
Drlg.

8-30

7" @ 4940/300
DD 4950 SP 4886, oil to surface in
1 hr 59 min
F 193 BO 19 hr

9-6

NR

COMPLETED

County Kiowa Elev. _____
 Sec. 27 Twp. 29 Rge. 18W
 Company Ohio
 Farm Name Mollie Greenwood No. 1

TOPS	DEPTH	LOG	DATUM
Anb.			
TP.			
H.			
Tr.			
Dg.			
Bl.			
L.			
K.C.			
B.K.C.			
Ce.			
C.			
M.			
M.			
K.			
Mz.			
Mo.			
V.			
S.			
S.			
A.			
R.			
Pe.			
G.			
TD.			

Loc. in Sec. C NW SW
 Geol. _____
 Contr. H & H
 Pool Nichols

FIRST REPORT
 0
 3/8 mile

Date Comm. M I R AUG 1 1956

1956

R. G.

Co.
Lse.
No.
Sec.
T.
R.

County Kiowa Elev. 2196
 Sec. 27 Twp. 29 Rge. 1st
 Company Ohio
 Name Allie Greenwood No. 1

Co.

Loc.

No.

Sec.

T.

R.

SPS	DEPTH	LOG	DATUM	Loc. in Sec.
Ann				0.75 57
Ip				
H.				
Tr.				
Dg.				
Bl.				
L.	4296			
K.C.				Geol.
B.K.C.				Contr.
Ce.				4 2 H
C.				
M.	4902			Pool
M.				Nichols
K.				
Mz.				
Mo.				
V.				
S.				
S.				
A.				
R.				
Pe.				
G.				
TD.	4942			COMPLETE

Date Comm. I. I. AUG 8 '56 8-1-56 85/8 360
 1225 @ 2604 AUG 15 '56 @ 4055
 AUG 22 '56 DST 4896-4941 @ 1 hr
 @ 6 1/2" Flwd oil 30" rec 1250'
 oil + 100' SW FP 464-583
 BHP 1650/20 @ ahead. AUG 29 '56
 7" @ 4940/300 co DD 4950 TD
 Hall. PKR @ 4886 w/7" o to s.
 1 hr 59" Flw 19.3 BO + Tr w/o
 19 hr 20/64" ch. TP 75# SEP 5 '56

21

Flows 182 Bopd nolwta