

Kiowa

KANSAS

27


29

18W

SECTION _____ TOWNSHIP _____ RANGE _____

WELL NO. #5 Greenwood

COMPANY The Ohio Oil Co.

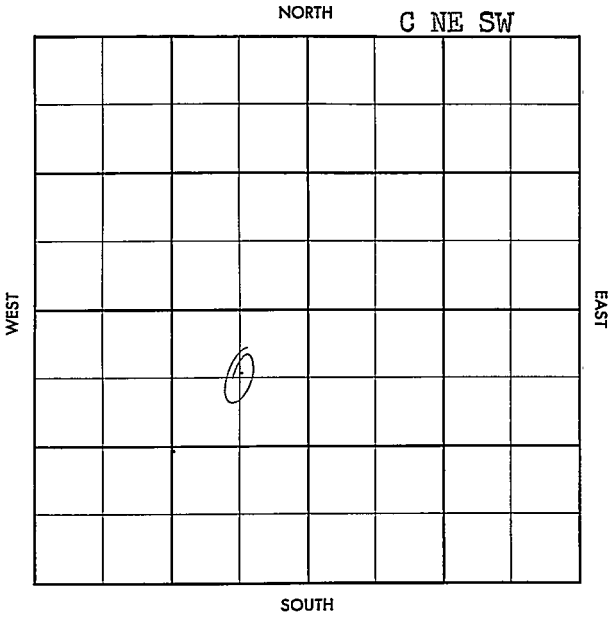

County Kiowa Elev. 2223 Gr.
 Sec. 27 Twp. 29 Rge. 18W
 Company The Ohio Oil Co.
 Farm Name Greenwood No. 5

TOPS	DEPTH	LOG	DATUM
Anh.			
TP.			
H.			
Tr.			
Dg.			
BL.			
L.			
K.C.			
B.K.C.			
Ce.			
C.			
M.			
M.			
K.			
Mz.			
Me.			
V.			
S.			
S.			
A.			
R.			
PE.			
G.			
T.D.			

Loc. in Sec.

C NE SW

Geol.

Contr.

Langford Drilg.

Pool

Nichols

FIRST REPORT

FEB 27 '50

Date Comm.

R U R

No.

Sec.

T.

R.

FORM 513 SURVEY

2234 DF

County SiouxElev. 2223 Gr.Sec. 27Twp. 29Rge. 18WCompany The Ohio Oil Co.Farm Name GreenwoodNo. 5

TOPS	DEPTH	LOG	DATUM	Loc. in Sec.
Anb.				C NE SW
Tr.				
H.				
Tr.				
Dg.				
Bl.				
L.				Geol.
K.C.	4347			Contr.
B.K.C.				Langford Dr
C.				Pool
M. chat	4956			Nichols
M.				
K.				
Mz.				
Ma.				
V.				
S.				
S.				
A.				
R.				
PE.				
G.				
TD.	4990			

COMPLETE

JUL 10 '57

Date Comm.

R U R 2-26-57 15' 4"

409/325 10' 30" 6' 4156

DST 4980-90 1 hr 6/30"

ga 40 MCFG rec 460' oil

+75' 0' 6 CM + 220' SW

FP 85-260 BHP 1625/30"

7" @ 4985/225 1" 57 CO 4920

\$ 29 1/2 Bo in 8 hrs 48/4976-84

55' 1/2 \$ 30 Bo in 12 hrs +

45% wtu Fr2c 4 x 4
 8 Ld. APR 10 '57 8 15 B0 + 15 BW
 in 5 hrs POP 100% 57 APR 24 '57 MAY 1 '57
 MAY 23 '57 JUN 10 '57 MAY 22 '57 MAY 29 '57 JUN 5 '57 JUN 12 '57
 JUN 19 '57 JUL 6 '57 JUL 13 '57 JUL 20 '57 P

76 Bopd no lwt.