KANSAS


Grant

FORM 51 5M BRIX

Section 28 Township 29 Range 35W

Well No. #1 Lakey

Company United Prod.

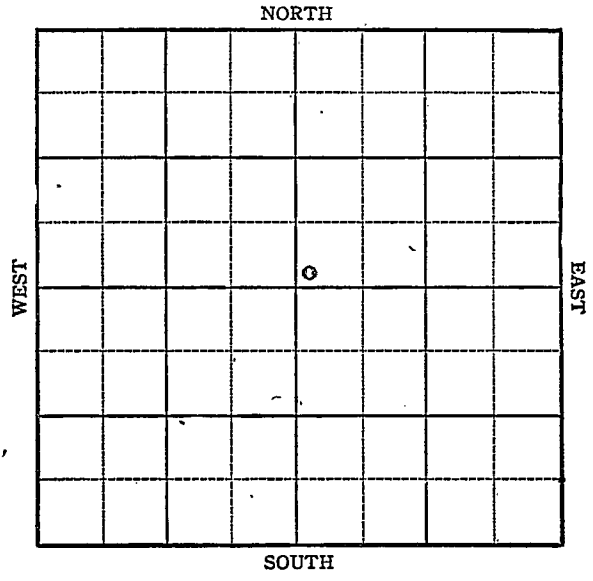

FORM 252-A
5M 9-44 PETROL

KANSAS Grant

Sec. 28 Twp. 29 R. 35W

Well No. #1 Lakey Farm

United Prod Company

Hugoton


____ Ft. from N. Line

100 Ft. from S. Line

____ Ft. from E. Line

100 Ft. from W. Line

SW NE

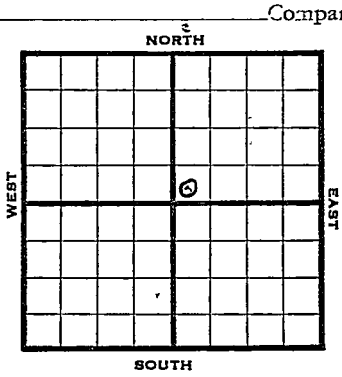

1945	Elev. 2980. REPORT
1/24	Location
1/31	RUR
2/7	10" @ 680 WOC
2/14	7" @ 2593 Rust
2/21	" " " "
2/28	TD 2593
3/7	" "
3/14	Drlg 2620
3/23	TD 2695'
	229' of 5" Perf. liner @ 2695
3/29	" " " " " " "
4/5	" " " " " " "
4/12	8000 acid.
4/20	" "
4/27	" "
5/3	" "
5/10	" "
5/17	" "
5/24	" "
5/31	" "

OVER

1945

6/13 7" @ 2593'
229' of 5" Perf Liner @ 2695
8000 acid
7,156,000 Gas
428# RPr
TD 2695.

COMPLETED

FORM 56 200 BKS. 1-44 PETROL

Pool Name Hugoton

Map No. NM Sec. 28 Twp. 29 R. 35W


Well No. 1 Lakey

United Prod Company

FIRST REPORT Contractor

SW NE

SECTION PLAT

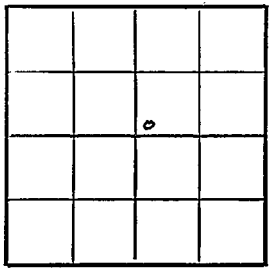

____ Ft. from N. Line

100 Ft. from S. Line

____ Ft. from E. Line

100 Ft. from W. Line

Grant

Location X

Rig up

Drilling and Remarks:

RECORD

Cased ____ in., ____ ft.

Sand

Gas

Oil

Total Depth

PRODUCTION

1st 24 hrs. Nat.

1st 24 hrs. after shot

Gas ____ Cu. Ft.


Dry Hole

Abandoned

Date

JAN 24 1945 19 S. J. LEWIS Scout

no wall map

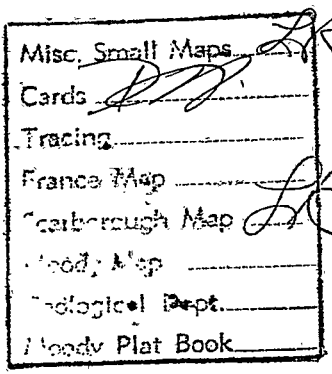
Misc. Small Maps
Cards
Tracing
France Map
Scarborough Map
Moody Map
Geological Dept.
Moody Plat Book

FORM 26 200 BKS 1-44 PETROL

Kansas Pool Name Hugoton

Map No. 116 SW cor Sec. 28 Twp. 29 R. 35W

Well No. 1 Lahey


United Prod. Company

COMPLETED Contractor

SW NE

E/ 2980

SECTION PLAT

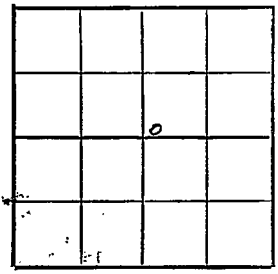

Ft. from N. Line

100 Ft. from S. Line

Ft. from E. Line

100 Ft. from W. Line

Grant County

Location

Rig up

Drilling and Remarks:

7" @ 2583

229' of 5" Perf liner @ 2695

8000 acid

7,156,000 Gas

428 RP

RECORD

Cased in., ft.

Sand

Gas

Oil

Total Depth 2695

PRODUCTION

1st 24 hrs. Nat.

1st 24 hrs. after shot

Gas Cu. Ft.


Dry Hole

Abandoned

Date

JUN 13 1945 19

S. J. LEWIS Scout

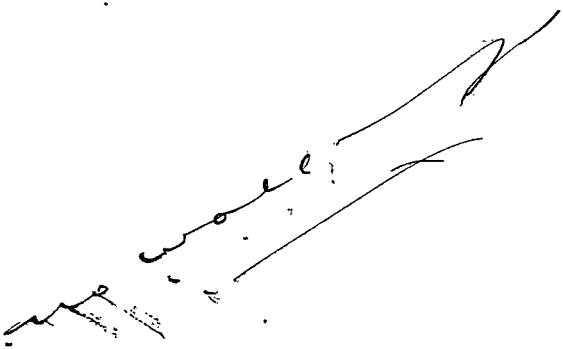

Misc. Small Maps
Cards
Tracing
France Map
Scarborough Map
Pierce Map
Geological Dept.
Pierce Plat Book