

Kiowa

KANSAS

28

29

18W

SECTION \_\_\_\_\_ TOWNSHIP \_\_\_\_\_ RANGE \_\_\_\_\_

WELL NO. #2 Koehn

COMPANY Gulf Oil & Falcon-Seaboard

NORTH

WEST

EAST


SOUTH

SEC. 28	TWP. 29	R. 18W
---------	---------	--------

WELL NO. #2 Koehn FARM

COMPANY Gulf Oil & Falcon-Seaboard

CONTRACTOR


Nichols

\_\_\_\_\_ Ft. from N. Line

\_\_\_\_\_ Ft. from S. Line

\_\_\_\_\_ Ft. from E. Line

\_\_\_\_\_ Ft. from W. Line

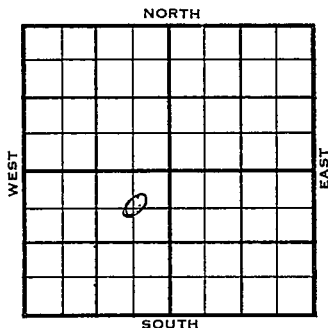

C NE SW

	ELEVATION	REPORT
1956	2200'	
4-11	Location	
5-23	Spud 4-14-56 8 5/8" @ 394 w/250 Cored 4910-39 DST 4914-29 op 1 hr. 870' gas, rec. 347' HGCM, BHP 1654/30". DST 4914-40 op 1 hr. gas to surf. in 11 min., rec. 140' HG&OCM / 185' gssy oil, BHP 1642/30" DST 4939-63 op 48 min. gas to surf. in 4 min., flw oil in 42 min., est <del>#####</del> 105 BOPH, FP 260-1005, BHP 1650 5 1/2" @ 5033 w/125 CO 4992, 48/4947-59, frac Flw 70 BO, no/wtr. in 5 hrs., 18/64" ch /# 132 MCF, CP 0#, TP 300#. BH Bomb Flw 3000 BOPD, Grav. 37 H. 4106', Dg. 4158', L. 4316', M. Chert 4912' Log tops: H. 4101', Dg. 4151', L. 4312', Marm 4766', M. Chert 4911', M. Base 4966' TD 5034'	

COMPLETED

Co.

County Kiowa Elev. \_\_\_\_\_  
 Sec. 28 Twp. 29 Rgs. 10W  
 Company Gulf Oil & Falcon-Seaboard  
 Farm Name Koehn No. 2

TOPS	DEPTH	LOG	DATUM
Anh.			
Tp.			
H.			
Tr.			
Dg.			
Bl.			
L.			
K.C.			
B.K.C.			
Ce.			
C.			
M.			
M.			
K.			
Mz.			
Ma.			
V.			
S.			
S.			
A.			
R.			
PE.			
G.			
T.D.			

Loc. in Sec. C NE SW

Geol. \_\_\_\_\_  
 Contr. \_\_\_\_\_

Pool Nichols

**FIRST REPORT**  
 0  
 APR 11 '56

Loc.


Date Comm. \_\_\_\_\_  
 Location \_\_\_\_\_

~~APR 1 7 1956~~

County Iowa Elev. 2200  
 Sec. 28 Twp. 29 Rge. 18W  
 Company Gulf Oil & Refining-Seaboard  
 Farm Name Behn No. ?

TOPS	DEPTH	LOG	DATUM
Anh			
TP			
H.	4106	4101	
Tr.			
Dg.	4158	4151	
BL			
L.	4316	4312	
K.C.			
<del>BKE</del> Marm		4766	
Ce.			
C.			
M. chert	4912	4911	
M. Base "		4961	
K.			
Mz.			
Mo.			
V.			
S.			
S.			
A.			
R.			
PE.			
G.			
TR	5034		

Loc. in Sec. C NE SW  
 Geol. \_\_\_\_\_  
 Contr. \_\_\_\_\_  
 Pool \_\_\_\_\_  
 Nic. oil. \_\_\_\_\_

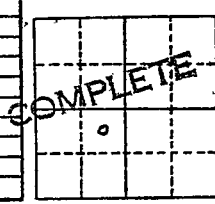

Date Comm. MAY 23 1956  
 Location APR 18 '56 4-14-56 85/8  
394/250 @ 2495 APR 25 '55 @ 4200  
MAY 2 '55 crd 4910-39 DST 4914-29  
1hr 870' gas rec 347' HGCM  
BHP 1654/30" DST 4914-40 1hr  
9 to 5. 11" TSTM rec 140' HGCO  
CM + 185' gssy oil BHP 1642/30"  
MAY 9 '56 DST 4939-63 gas 48"  
6 to 5. 4" Flw oil 10 42"

Co.  
 Lse.  
 No.  
 Sec.  
 T.  
 R.

28 - 29 - 18W

FORM 513-1 SUNRAY

EST 105 Boph FP 260-1005  
BHP 1650 5 1/2 @ 5033/125  
CO 4992 48 / 4947-59  
Frac Flw 70 Bo no/w in <sup>MAY 15 '56</sup>  
5 hrs 18/64" ch + 132 MCF  
CP 0 TP 300 <sup>MAY 23 '56</sup> BH Bomb  
Flw 3000 Bopd grav 37°