


DX 78-1 Kiowa

KANSAS

Section 28 Township 29 Range 18W

Well No. #6 Koehn

Company Gulf Oil et al

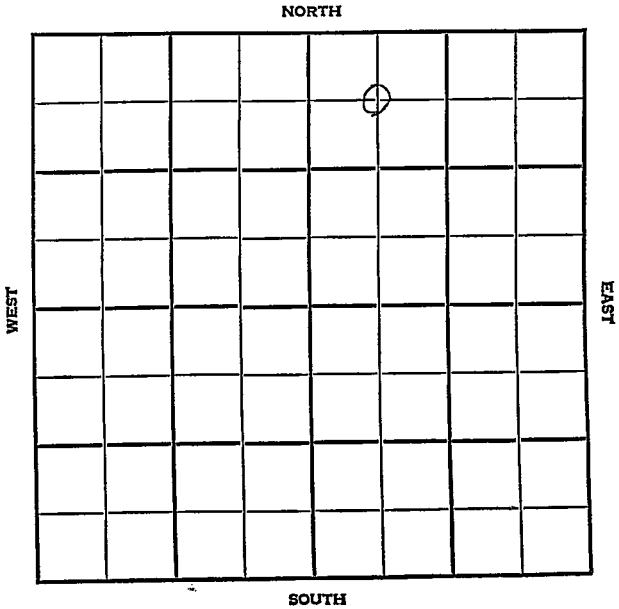

SEC. 28	TWP. 29	R. 18W
------------	------------	-----------

WELL NO. #6 Koehn

COMPANY Gulf Oil Etal FARM

CONTRACTOR Falcon-Seaboard


Nichols

\_\_\_\_\_ FT. FROM N. LINE

\_\_\_\_\_ FT. FROM S. LINE

\_\_\_\_\_ FT. FROM E. LINE

\_\_\_\_\_ FT. FROM W. LINE

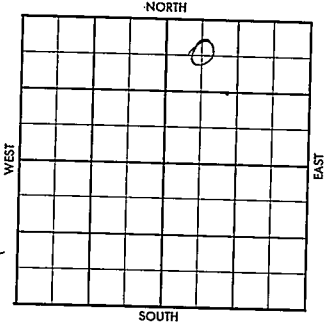

~~C NW NE~~ C E/2 NW NE

1956	ELEVATION	REPORT
------	-----------	--------

7-3 Location



# CORRECTION

FORM 513 SUNRAY

County Knowl Elev. 2200  
 Sec. 28 Twp. 29 Rge. 1E  
 Company: Curt Oil etal.  
 Farm Name Open No. 6

TOPS	DEPTH	LOG	DATUM	Loc. in Sec.
Anh.				C 117-
Tr.				
H.	4128	4129		C 117 NA 1E
Tr.				
Dg.	4158	4160		
Bl.	4302	4303		
L.	4318	4322		
K.C.				Geol.
B.K.C. <u>MARD</u>	4748	4740		Contr.
Ce.				Falcon-Seaboard
C. <u>M. Chem</u>		4725	2562	
M.	<del>4807</del>	<del>5026</del>		Pool
M.				Richols
K.				
Mz.				
Ma.				
V.				
S.				
S.				
A.				
R.				
PE.				
G.				COMPLETE
TD.	5065			

Date Comm. \_\_\_\_\_  
 Location JUL 11 '56 JUL 18 '56 JUL 23 '56  
7-22-56 858 374 1200 AUG 1 '56  
11 3912 AUG 8 '56 11 4940  
AUG 15 '56 DST 4953-80 1hr. 9 1/2"  
92 93 MCF net 3580' 9554 oil  
FP 165-835 BHP 1625/30" 5 1/2  
@ 5064/125 CO PB 5030 32/  
4968-76 1/4 FRAG 4x4 F/W  
300 B0 + 95 BW 15hr 2 1/4" ch.  
AUG 22 '56 AUG 29 '56

Flw 181 Bop + 85 BW 24 hrs  
 17/64" ch <sup>SEP 5 '55</sup> Killed well  
 4/4990 cem PF 4968-76  
 § 4990 woc. <sup>SEP 22 '55</sup> PB 4982  
 16/4970-74 1/4" FRAC 4 x 4  
 Flwd 372 BF 12% w  
 17 hrs 24/64" ch TP 750 CP  
 800 <sup>SEP 19 '56</sup> <sup>SEP 20 '56</sup> F 1420  
 Bopd + 7% wtr <sup>gras 36°</sup>  
 OCT 3 '56 Draw down 1420  
 Bopd + 6% wtr  
 gras 36°