


DX 78-1 Kiowa

KANSAS

Section 28 Township 29 Range 18W

Well No. #7 Koehn

Company Gulf Oil et al

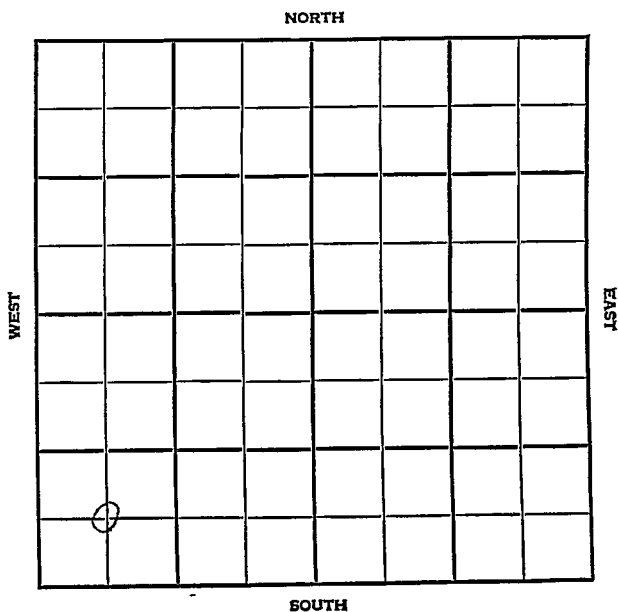

Kiowa

KANSAS

SEC.

28

TWP.

29

R.

18W

WELL NO.

#7 Koehn

FARM

COMPANY

Gulf Oil,etal

CONTRACTOR

Falcon-Seaboard

Nichols


____ FT. FROM N. LINE

____ FT. FROM S. LINE

____ FT. FROM E. LINE

____ FT. FROM W. LINE

C SW SW

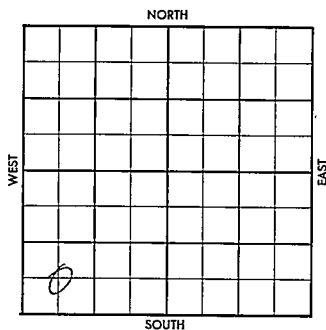

1956

ELEVATION

REPORT

7-3

Location

County Kiowa Elev. _____
 Sec. 28 Twp. 29 Rge. 18W
 Company Gulf Oil, etal.
 Farm Name Koehn No. 7

TOPS	DEPTH	LOG	DATUM	Loc. in Sec.
Anh.				C SW SW
Tr.				
H.				
Tr.				
Dg.				
BL.				
L.				Geol. _____
K.C.				Contr. _____
B.K.C.				Falcon-Seaboard
Ce.				
C.				
M.				Pool _____
M.				Nichols
K.				
Mz.				
Me.				
V.				
S.				
S.				
A.				
R.				
Pe.				
G.				
T.D.				

FIRST REPORT			
JUL 3 1956			
0			

Date Comm. _____
 Location _____

3301 1 1 JUL

County	Kiowa	Elev.	41'	Co.		
Sec.	28	Twp.	29		Rge.	18W
Company	Gulf Oil, et al.					
Farm Name	Koen	No.	7			

TOPS	DEPTH	LOG	DATUM	Loc. in Sec.
Anh.				
Tr.				
H.	4112	4114		
Tr.				
Dg.	4145	4146		
BL.				
L.	4302	4310		
K.C.				Geol.
B.K.C. Marm	4745			Contr.
Ce.				Falcon - Leabers
C.				Pool
M. chert		4934	2.14	Nichols
M. LI		4968		
K.				
Mz.				
Mo.				
V.				
S.				
S.				
A.				
R.				
Pe.				
G.				
T.D.	5050			

Date Comm.			
Location	JUL 11 '56	JUL 18 '56	JUL 25 '56
AUG 8 '56	AUG 5 '56	8-10-56 85/8	
349/225	2495	AUG 22 '56	
4362	1329 '56	DST 4522-48	
1hr 465'	WM	BHP 1470/30"	
DST 49.30-45	1hr 2250' gae		
rec 10' Md + 125' Md (ssg)			
+120' HOS GCM + 28' Free oil			
BHP 1285/20	DST 4945-60		

COMPLETE

NOV 7 '56

No.

Sec.

T.

R.

1 hr sec 35' GCM + 90' 8' GCM
 + 90' Foamy oil + 90' 9554 oil
 5.5' 9554 oil CW + 40' SW
 BHP 1500/130" DST 4960-90
 1 hr 70' 9554 Md (550) + 30'
 9554 WCM + 50' SW BHP
 1545/120" D 5030 SEP 5 '56
 5 1/2 5052/250 PB 5010
 32/4940-48 Ma Frac 4x4
 SEP 12 '56 Flwd by heads 50 B0
 + 32 BW in 24 hrs 24/64" ch.
 SEP 19 '56 SEP 26 '56 Flw 9 B0 + 15
 BW 3 hrs S.I. OCT 3 '56
 OCT 10 '56 OCT 17 '56 OCT 24 '56 OCT 31 '56 P. 82
 B0 24 hrs NOV 7 '56 P. 82
 Bopd 34% wt