


Section 28 Township 29 Range 18W

Well No. #9 Koehn

Company Gulf Oil Corp.

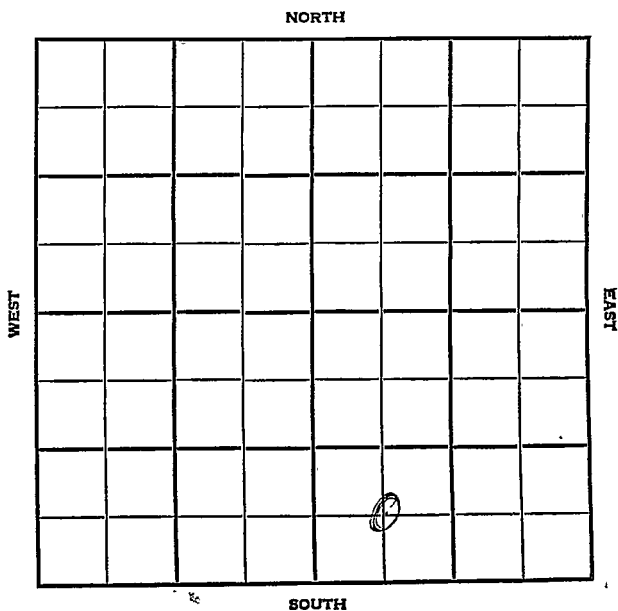



County Kiowa Elev. 111  
 Sec. 28 Twp. 29 Rgs. 18W  
 Company Gulf Oil Corp.  
 Farm Name Koehn No. 9

Co.

Loc.

No.

Sec.

T.

R.

TOPS	DEPTH	LOG	DATUM
Anh.			
Tr.		4110	
Dg.		4142	
Bl.		4288	
L.		4300	
K.C.	7		
B.K.C.			
Ce.			
C.			
M. <u>chert</u>		4906	
M. <u>cl</u>		5004	
K.			
Mz.			
Mo.			
V.			
S.			
S.			
A.			
R.			
PE.			
G.			
TD.		5040	

Loc. in Sec. C S. SE  
 Geol. \_\_\_\_\_  
 Contr. \_\_\_\_\_  
Falcon Sea-Board Tools Pool  
Nichols

COMPLETE  
 JAN 23 '57

Date Comm.

Location NOV 28 '55 ✓ CS 5 '56 12-1-56  
8 7/8 372/225 S.D. 0373 DEC 1 '55  
10 4118 DEC 19 '56 DST 4919-49  
95" 6 1/4" Md in 12" oil in 15"  
est Flow 5 Boph ga + 2 Mill  
CFG BHP 1510 1384 5 1/2 5037  
1125 DEC 26 '56 CO 5004 24/4946-52  
114 Frac 1 1/2 x 1 1/2. Flowd  
25 Boph 6 hrs 144 2 '57 Jan 9 '57

Jth 5<sup>th</sup> Flwd 278 Bo 24 hrs  
+ ga 370 MCFG JAN 8<sup>th</sup> Flw  
135 Bo no/w 8 hrs 2 1/4" ch  
ga 363 MCF = GOR 898.1  
st +st Flw 405 Bopd no/w  
TP 525 #

28-29-18W

Cowley